


T.19S.R.47E.W.M.

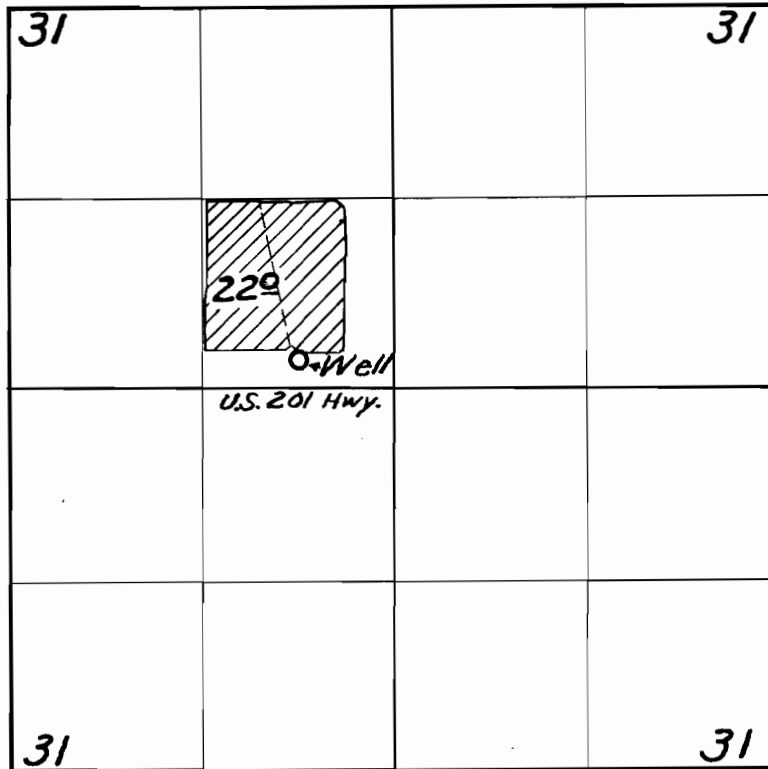

FINAL PROOF SURVEY

UNDER

Application No. U-737 Permit No. U-663

IN NAME OF

Frank N. Sherwood

Surveyed Oct. 13 1955 by M. Bish