



U-679

22904

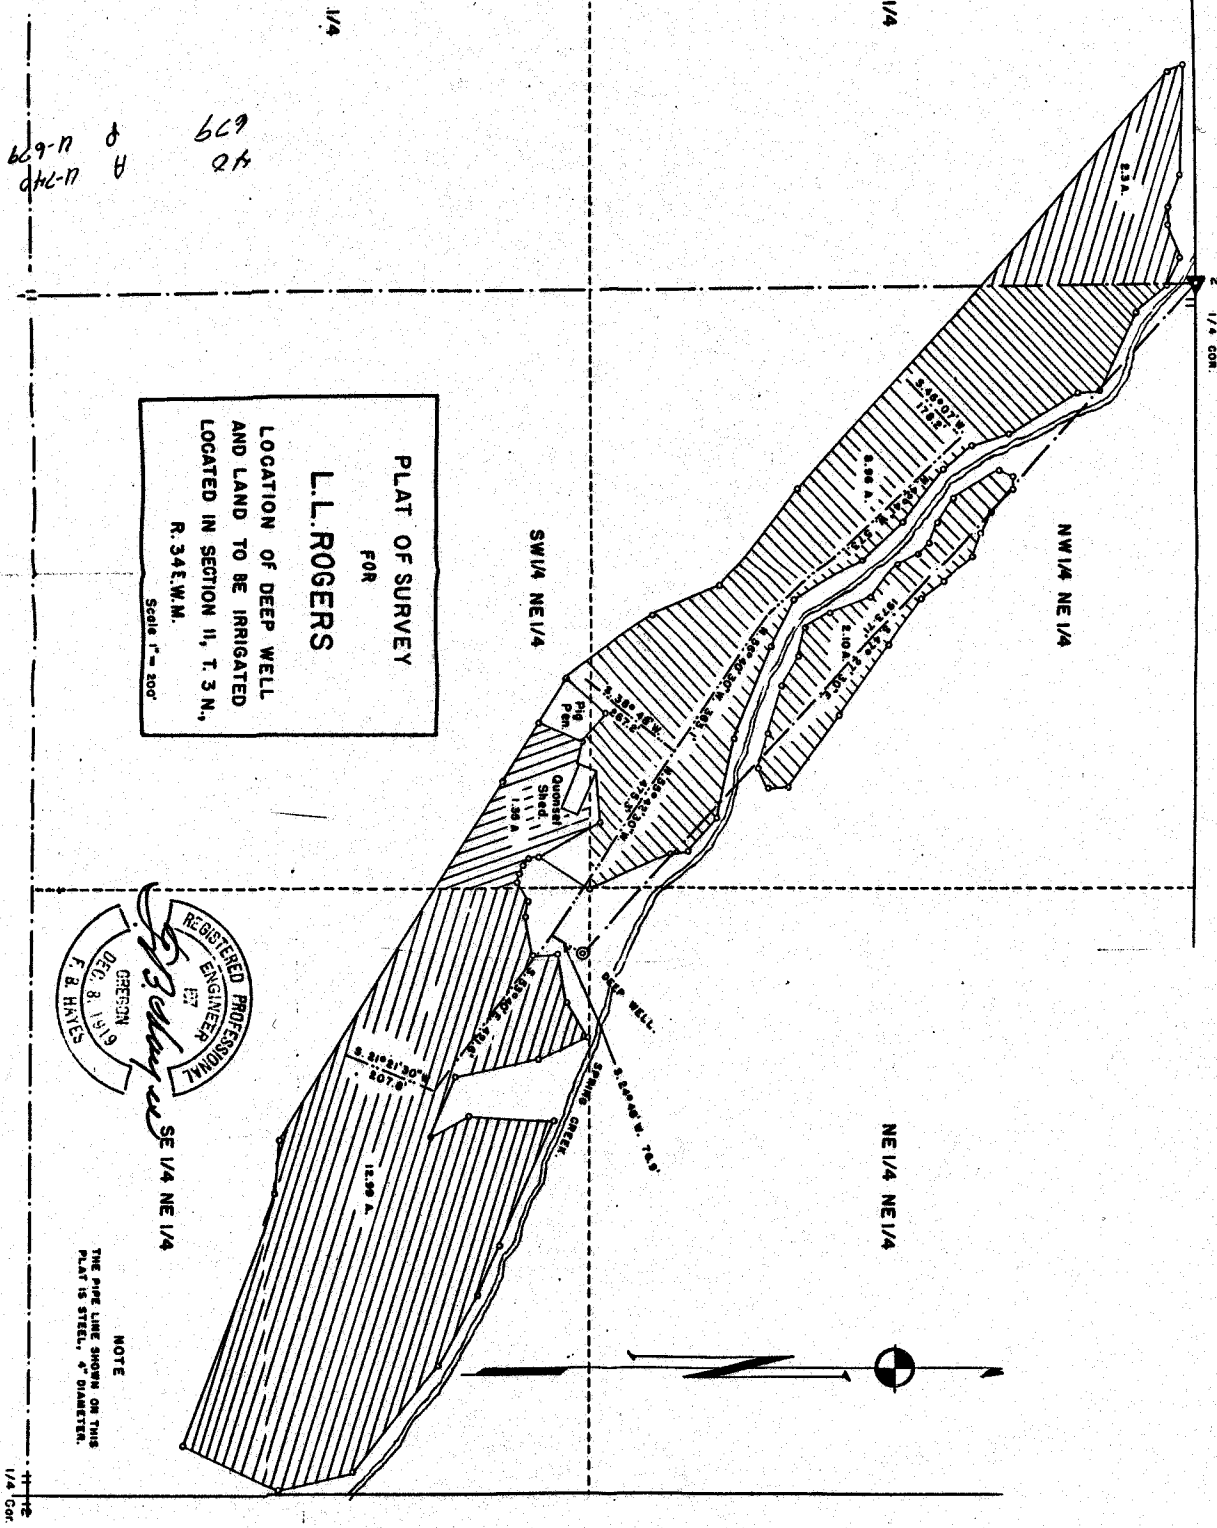

PLAT OF SURVEY
FOR
L.L. ROGERS
LOCATION OF DEEP WELL
AND LAND TO BE IRRIGATED
LOCATED IN SECTION 11, T. 3 N.,
R. 34 E. W.M.
Scale 1" = 200'

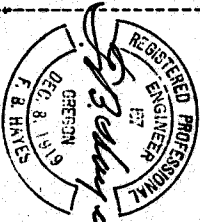

NOTE
THE PIPE LINE SHOWN ON THIS
PLAT IS STEEL, 8" DIAMETER.

679-11
8
8
679
24

679-11