


T. 9S. R. 40E. W.M.

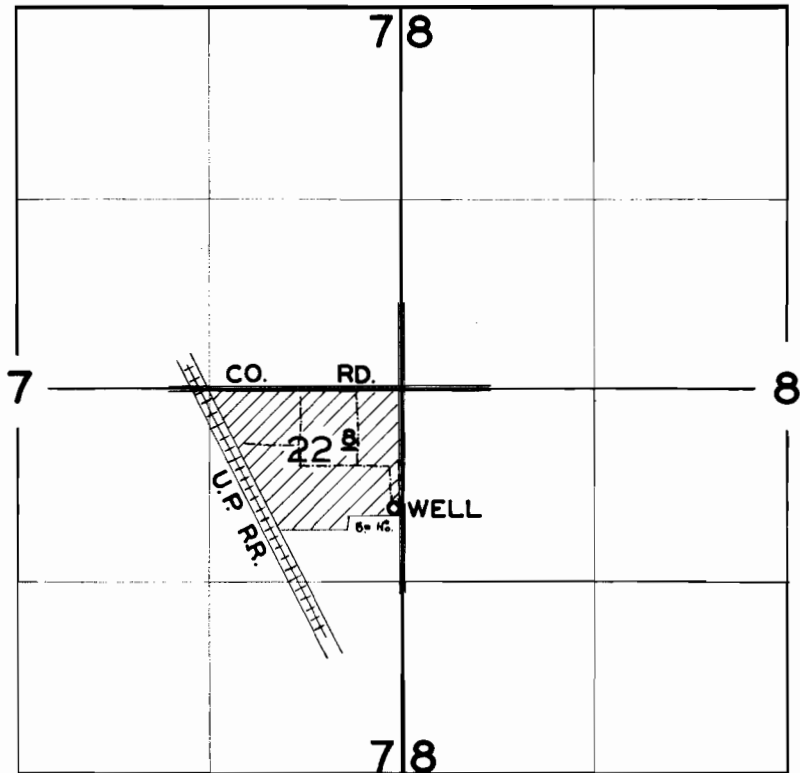

FINAL PROOF SURVEY

UNDER

Application No. U-807 Permit No. U-704

IN NAME OF

FRED BROWN

Surveyed 22 MAY 1956, by M. BISH

BBB - 4 N - 88

Revised