


T. 9 S. R. 40 E. W.M.

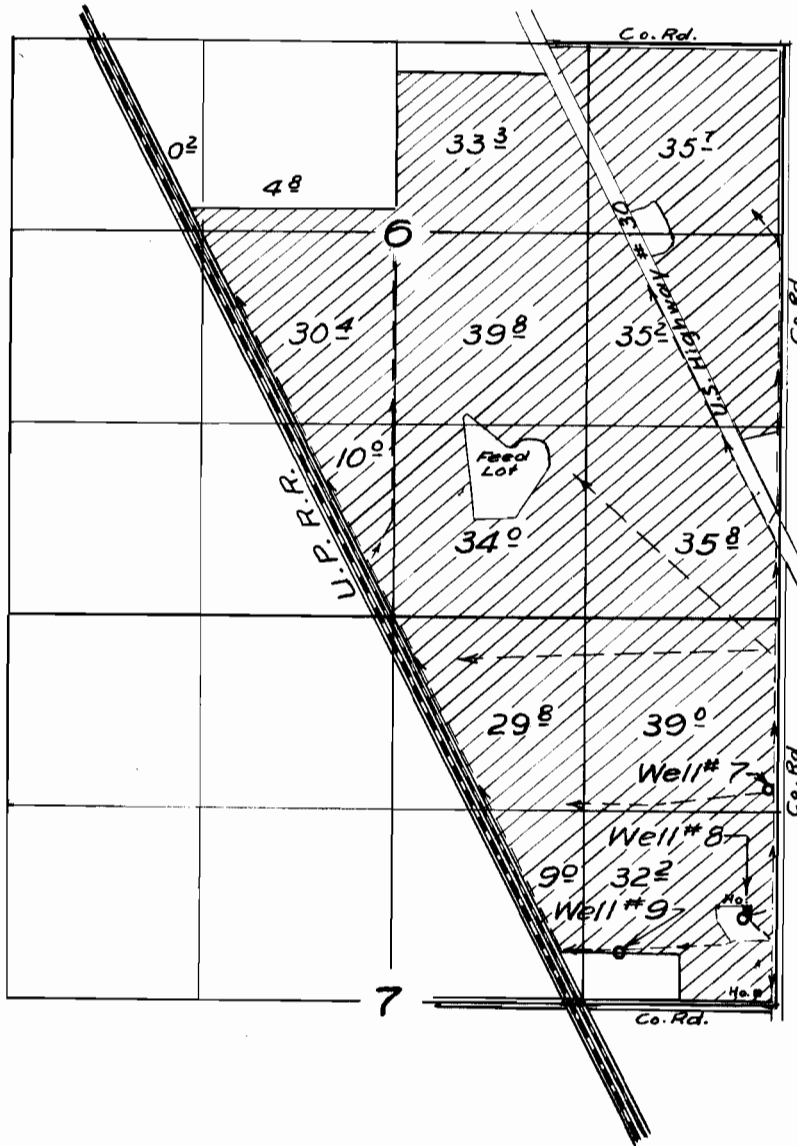

FINAL PROOF SURVEY

UNDER

Application No. *G-60* Permit No. *G-68*

IN NAME OF

Clyde Ward

Surveyed *22 May 1956* by *Tom Bush*