


T. 29 S. R. 5 W. W. M.

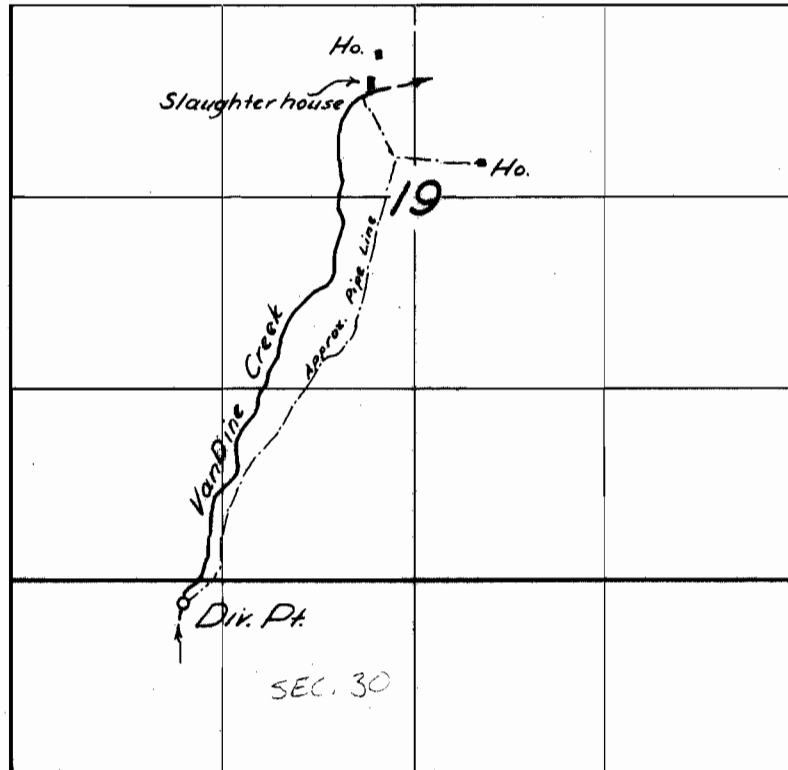

**FINAL PROOF SURVEY**

UNDER

Application No. 22520 Permit No. 17744

IN NAME OF

J. O. LEDGERWOOD & CLAY ULUM

Surveyed 3 Oct 1956, by [Signature]