


T.2N., R.3W., W.M.

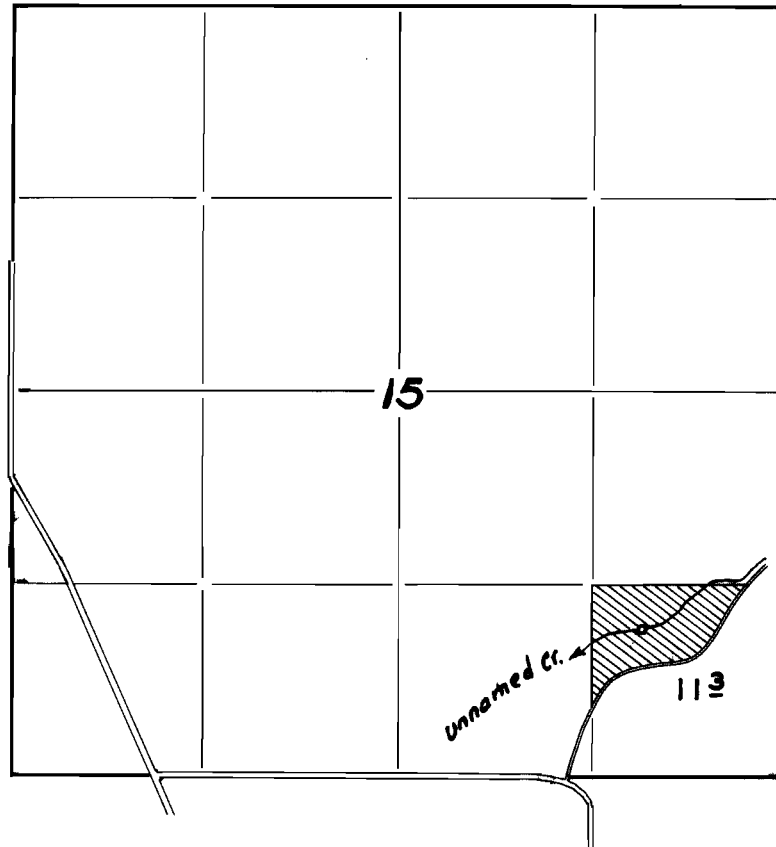

FINAL PROOF SURVEY

UNDER

Application No. 23909 Permit No. 18836
IN NAME OF

IRVING C. & HELEN R. CHASE

Surveyed 4 - 25 1956, by R. H. WHITBY.