


T. 3 N. R. 2 W. W.M.

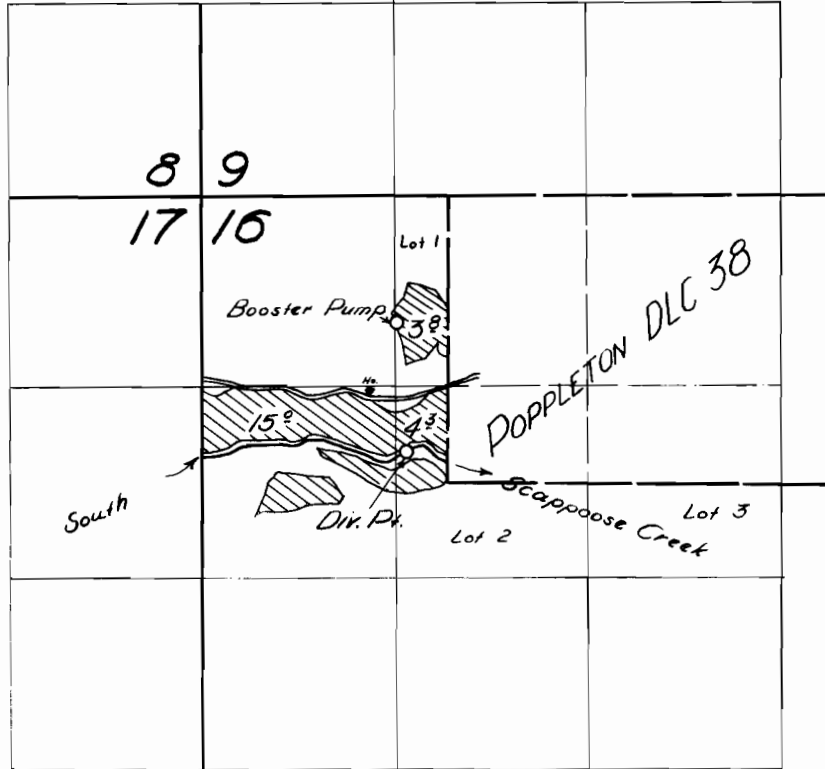

FINAL PROOF SURVEY
UNDER

Application No. 24567 Permit No. 19322
IN NAME OF

OTTO KOMNING

Surveyed 19 July 1956, by [Signature]