


T.1N. R.3W. W.M.

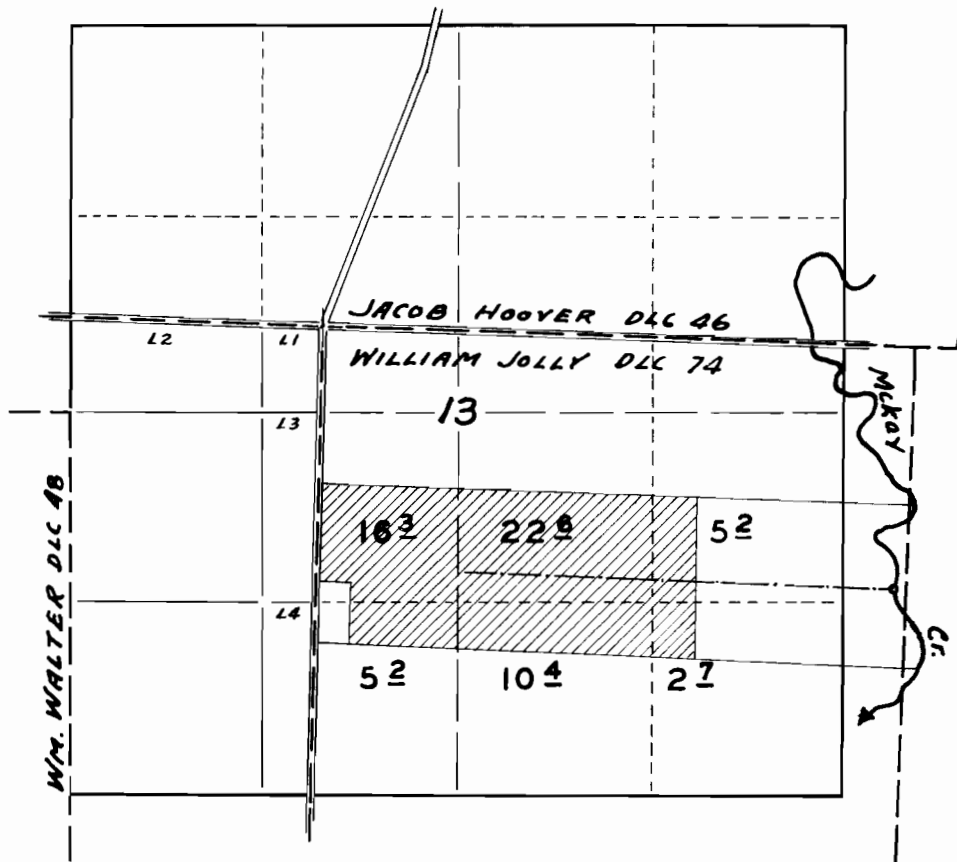

**FINAL PROOF SURVEY**

UNDER

Application No. 24839 Permit No. 19554.

IN NAME OF

ALFONS MAES

Surveyed 4 - 11, 1956, by M. BISH