


T.2S., R.2W., W.M.

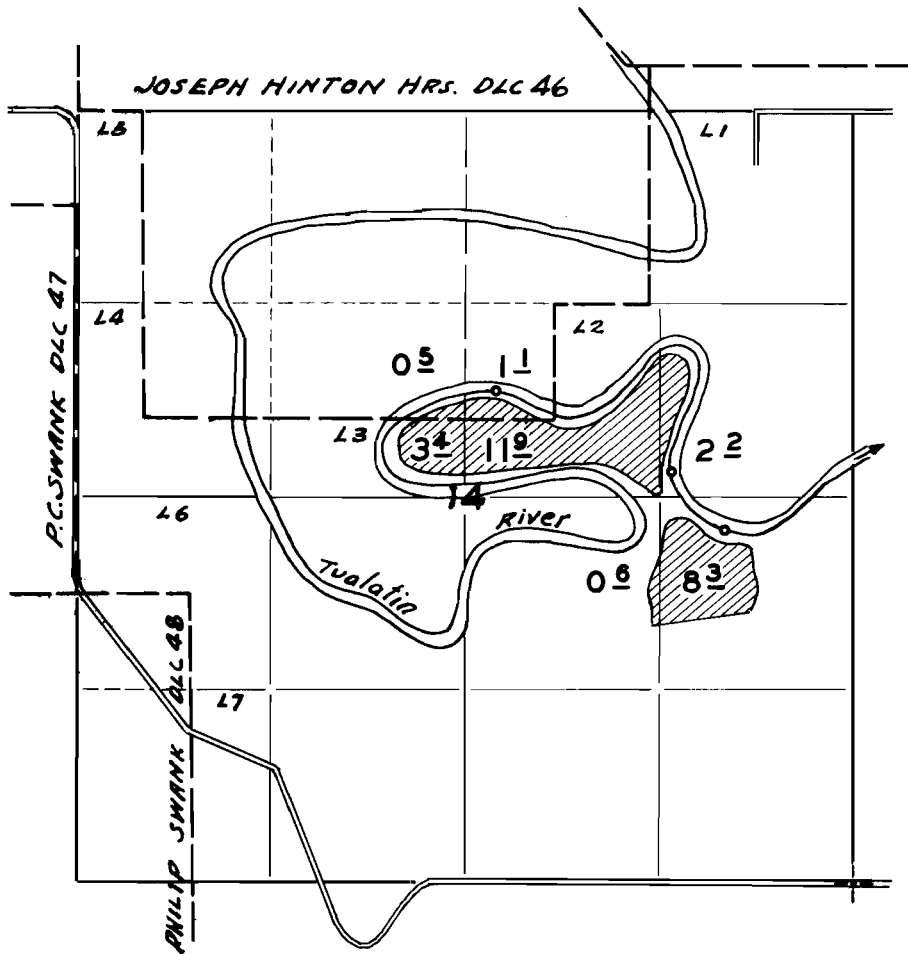

**FINAL PROOF SURVEY**

UNDER

Application No. 24881 Permit No. 19576

IN NAME OF

ROBERT F. FORSMAN

Surveyed 5 - 1, 1956 by M. BISH