


T. 2 S., R. 2 W., W. M.

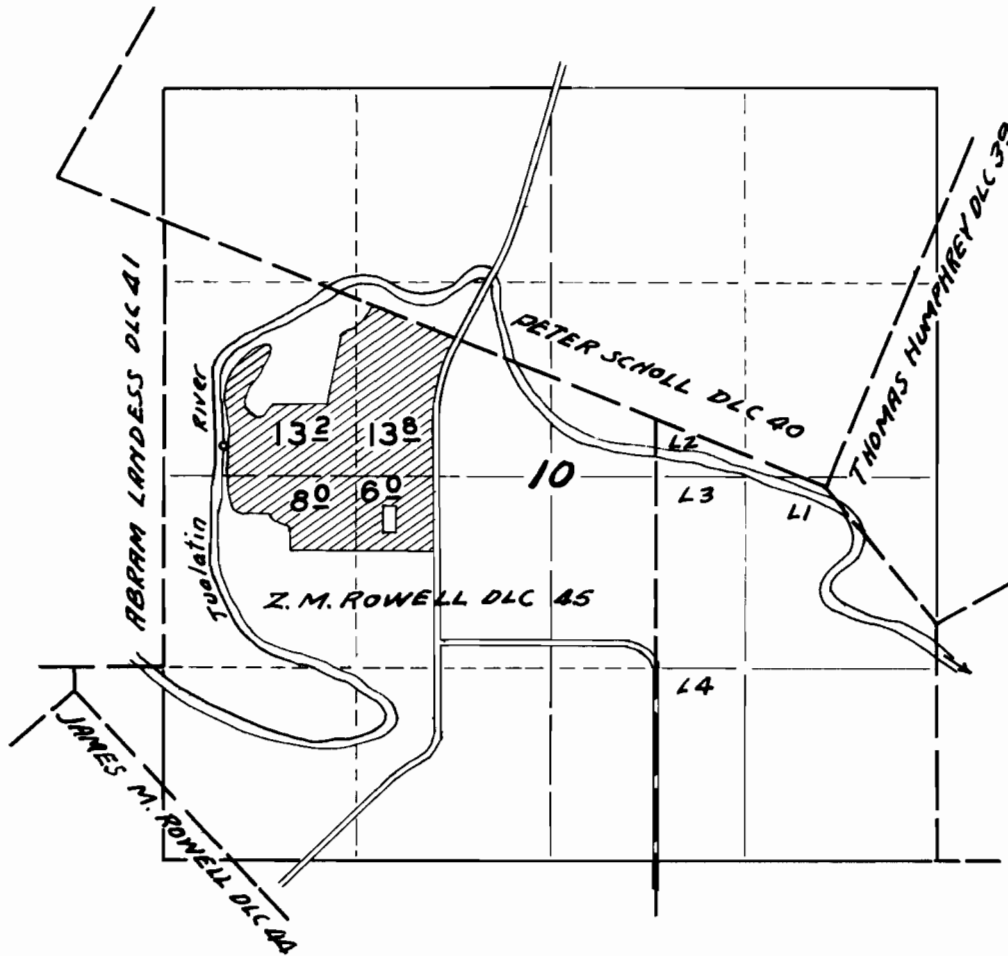

FINAL PROOF SURVEY

UNDER

Application No. 24908 Permit No. 19585

IN NAME OF

LOUIS C. STEELE

Surveyed 4 - 26 1956, by M. BISH