


T. 2 N., R. 2 W., W.M.

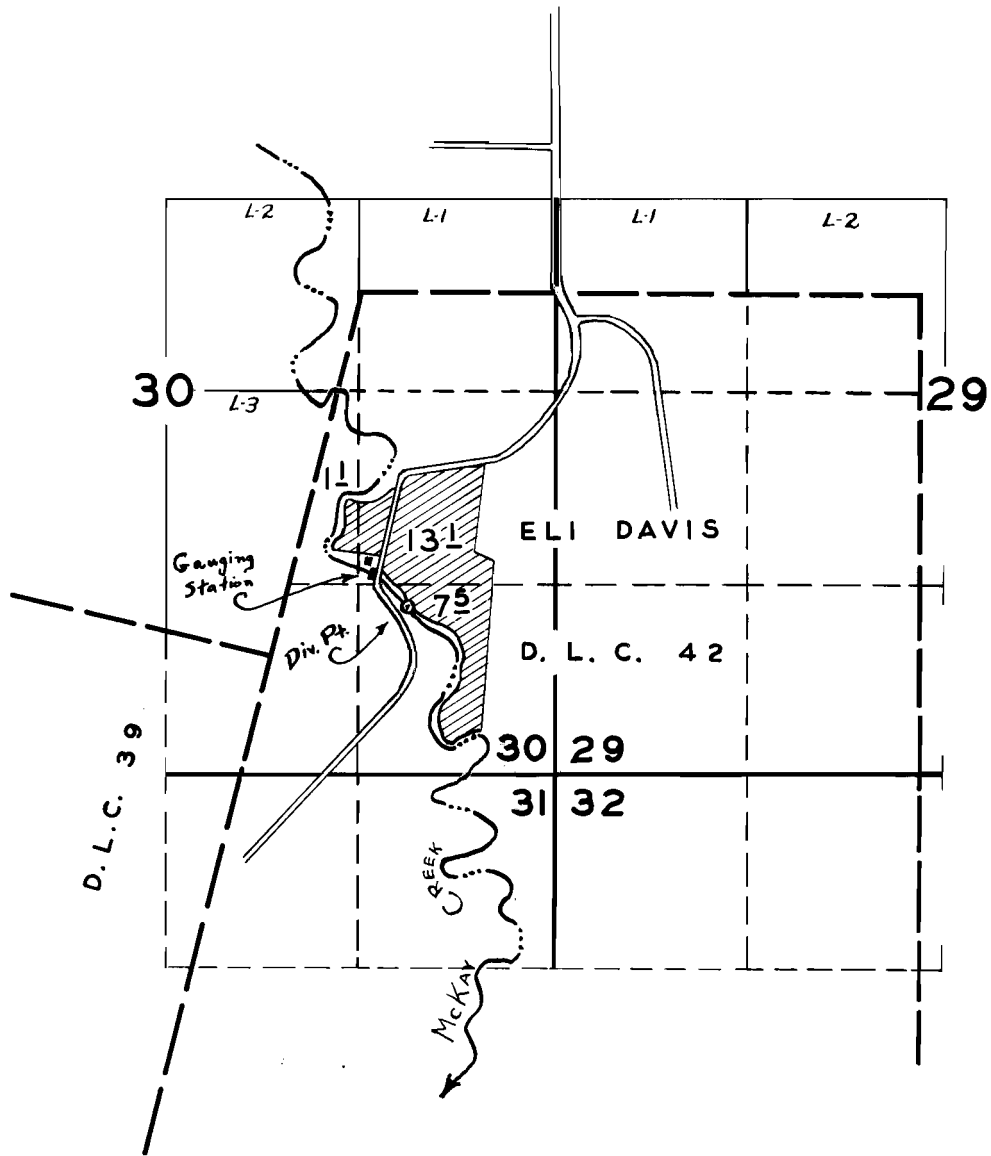

**FINAL PROOF SURVEY**  
UNDER

Application No. 25011 Permit No. 19621  
IN NAME OF

W. H. WAINSCOTT

Surveyed 4 - 12 1956, by M. BISH