T.1 S. R.3 W. W.M.

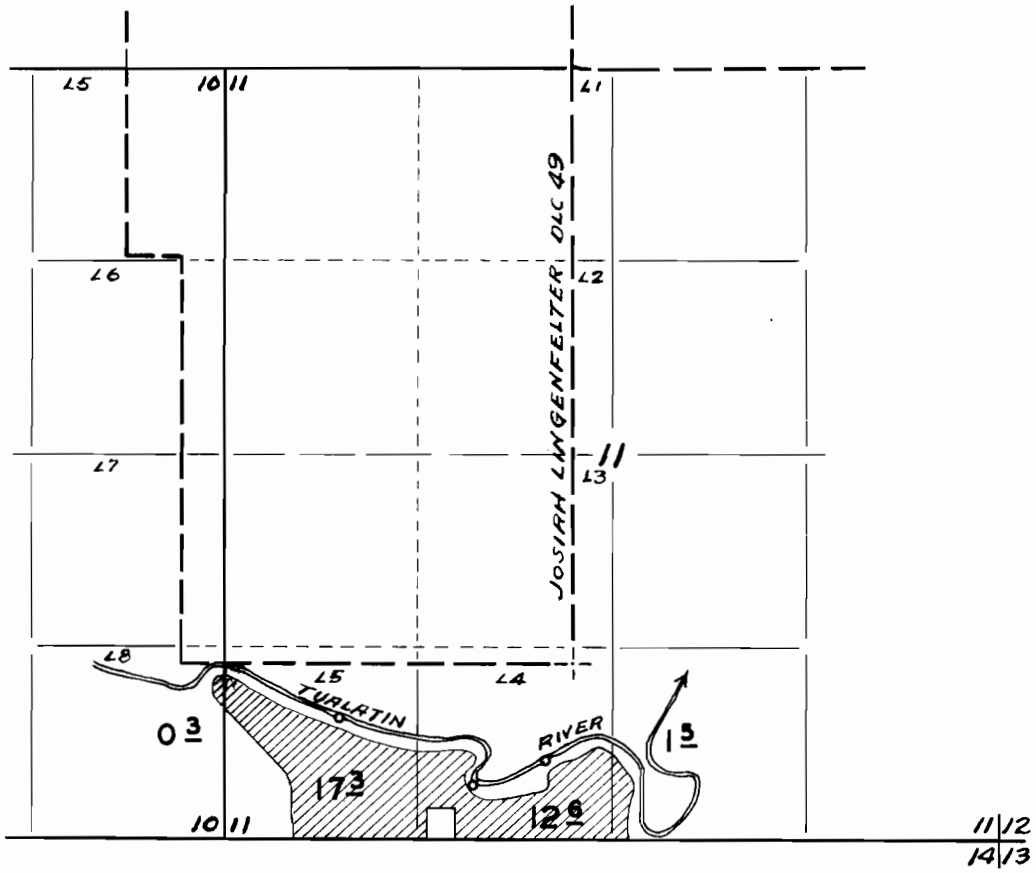

FINAL PROOF SURVEY

UNDER

Application No. 25044 Permit No. 19728

IN NAME OF

WM. E. JANSEN

Surveyed 4-27 1956, by R.H. WHITBY

DFR-2D-167 WC