
T. IS., R. 2W., W.M.

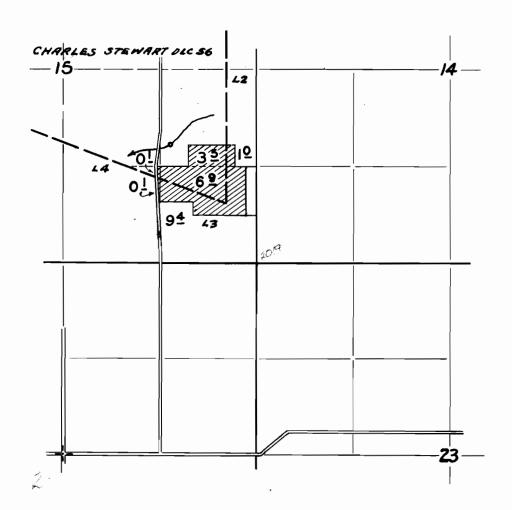

FINAL PROOF SURVEY

UNDER

Application No. 25060 Permit No. 19734
IN NAME OF

MIKE GRABOVAC

Surveyed 4 - 18 1956, by M. BISH