


T.2N. & 3N., R.3W., W.M.

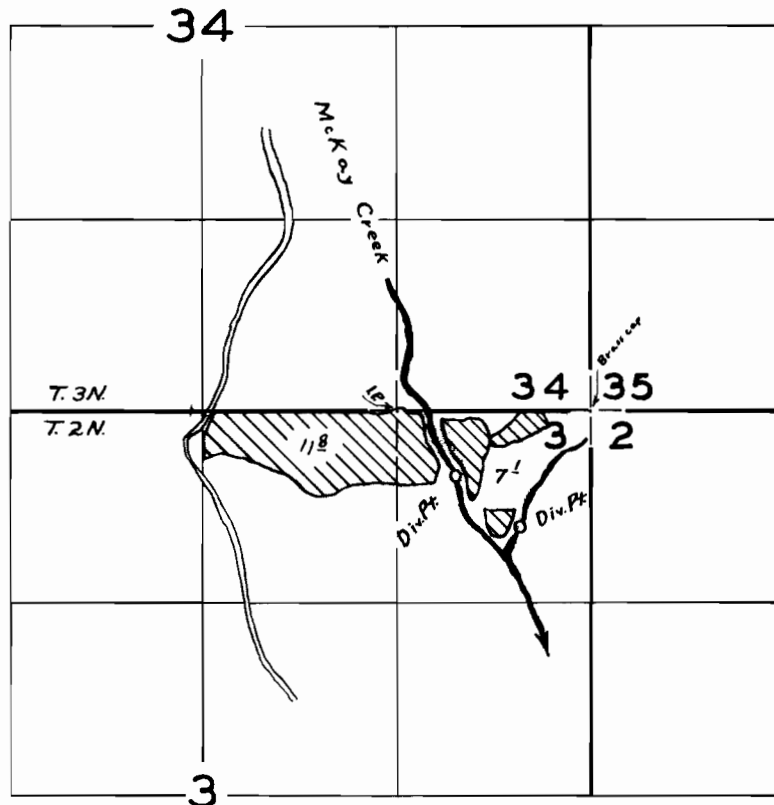

FINAL PROOF SURVEY

UNDER

Application No. 25161 Permit No. 19790
IN NAME OF

PHILIP GRUBER

Surveyed 4 - 19 1956, by R. H. WHITBY