


T. 1 S., R. 2 W., W.M.

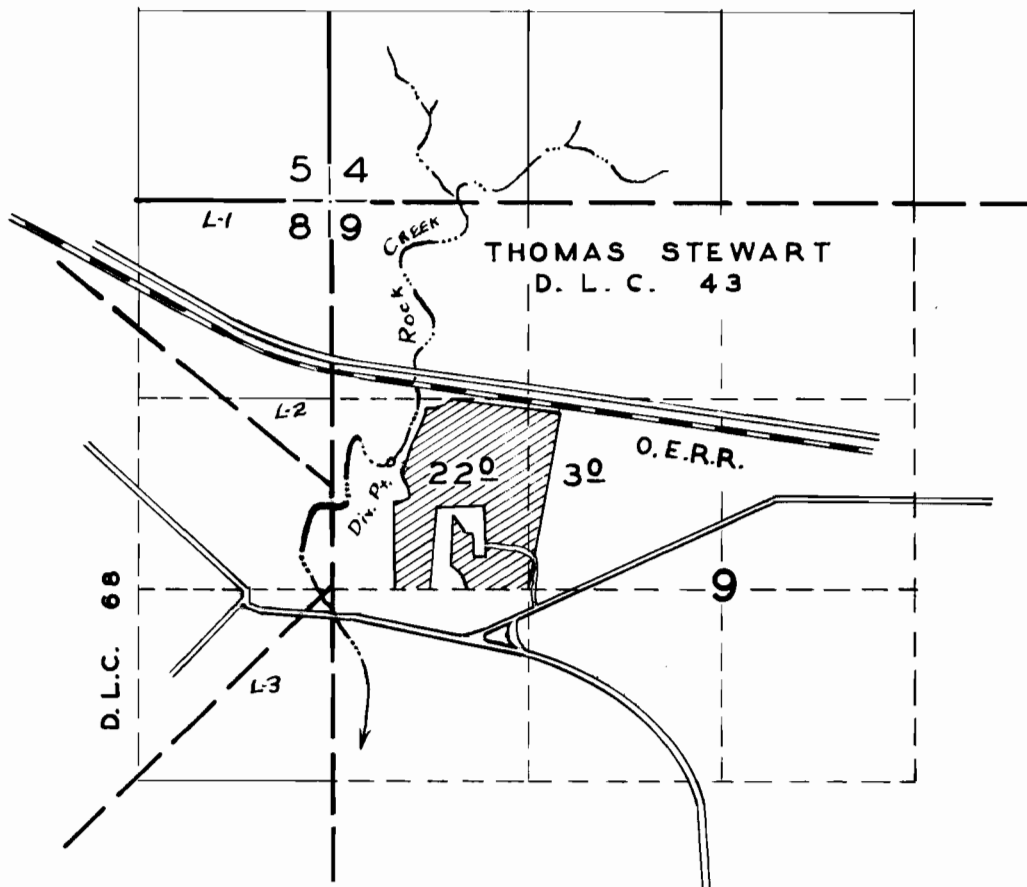

FINAL PROOF SURVEY

UNDER

Application No. 25550 Permit No. 20063

IN NAME OF

C. E. HAWKINSON

Surveyed 4 - 23 1956, by M. BISH