


T. 5 N. R. 2 W. W. M.

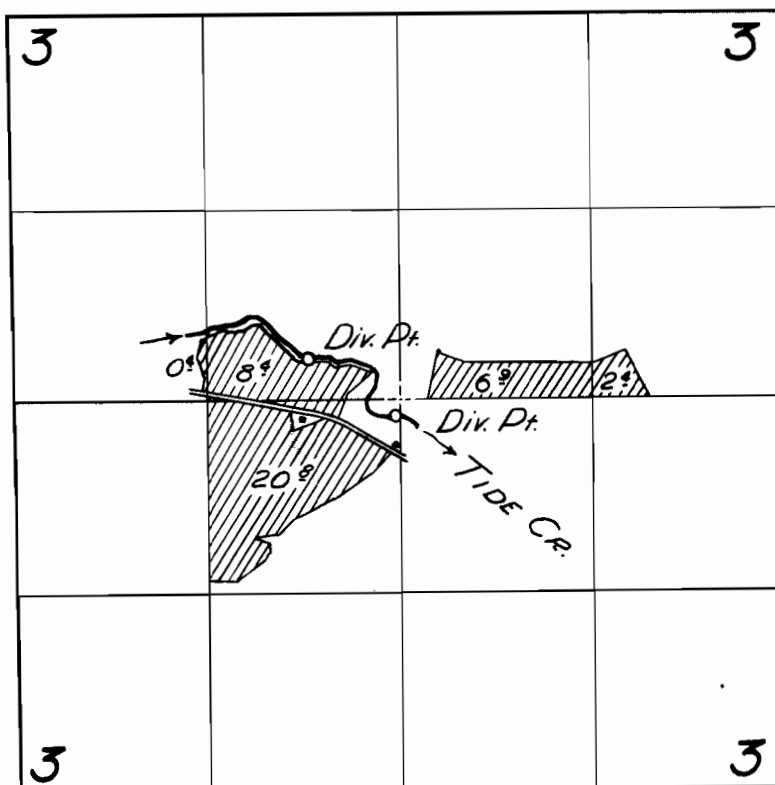

FINAL PROOF SURVEY

UNDER

Application No. 25689 Permit No. 20136

IN NAME OF

ADOLPH ANICKER

Surveyed 7 Aug. 1956, by [Signature]