


T. 30 S. R. 5 W. W.M.

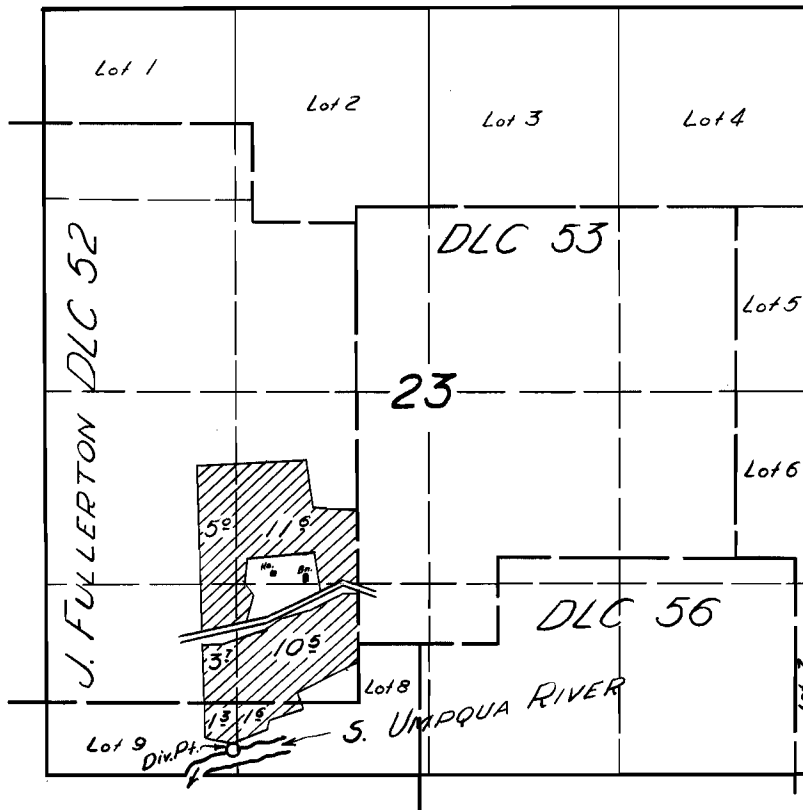

**FINAL PROOF SURVEY
UNDER**

Application No. 25696 Permit No. 20138
IN NAME OF

WEBSTER E. BRIGGS

Surveyed 14 Oct. 1956 by [Signature]