


T. 7N R. 3W W. M.

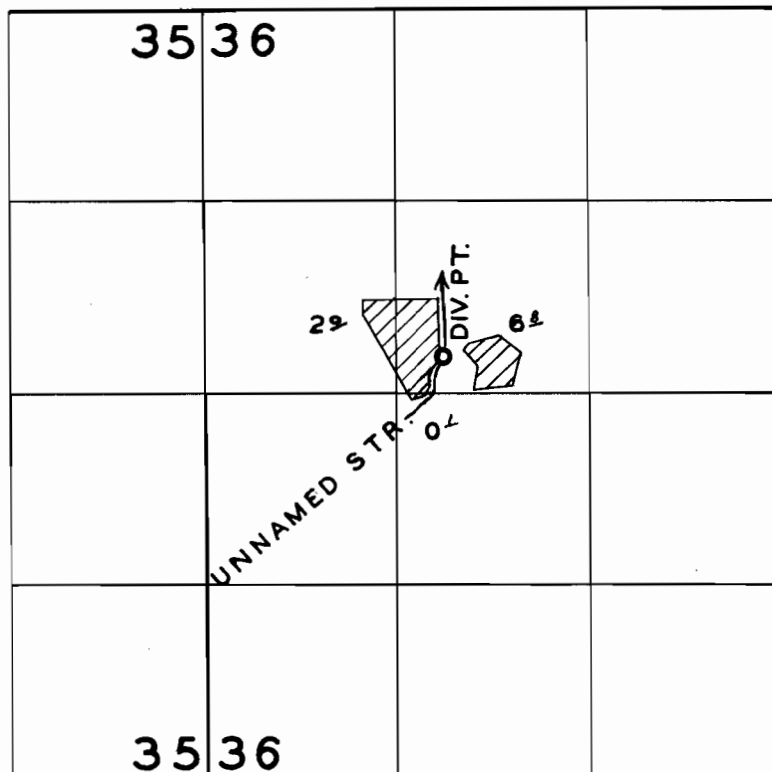

FINAL PROOF SURVEY
UNDER

Application No. 25733 Permit No. 20146
IN NAME OF

H. R. WENGERT

Surveyed AUG. 23, 1956, by R. H. WHITBY

1956 V
L. W. J.