


T.2 S., R.1 E., W.M.

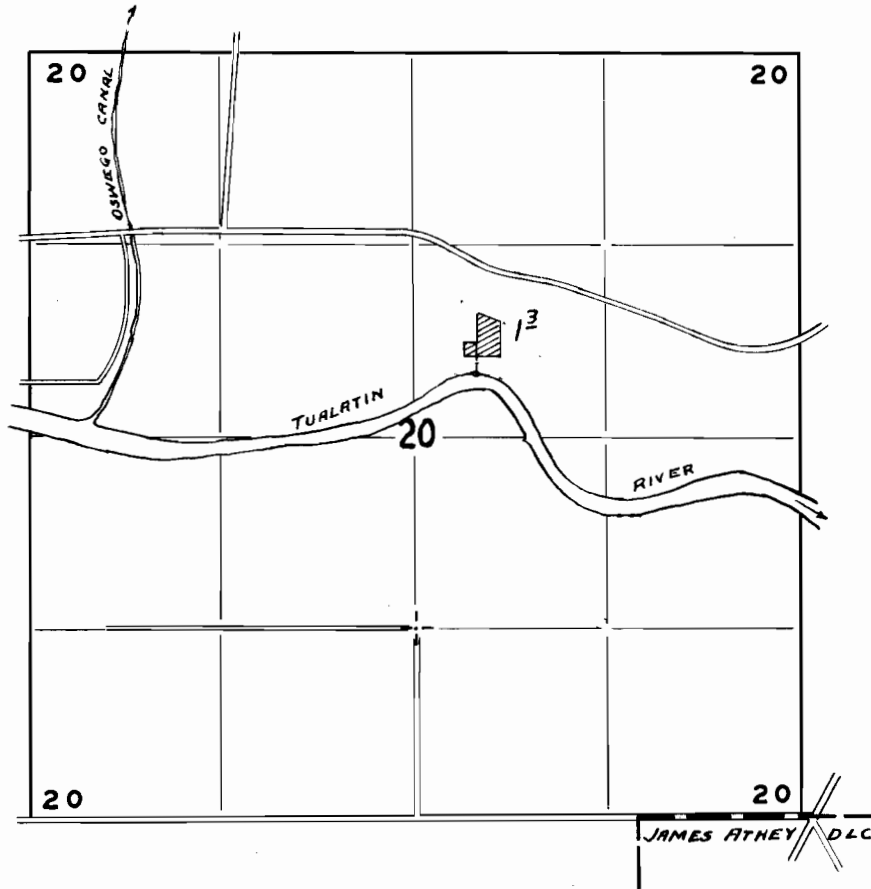

**FINAL PROOF SURVEY**

UNDER

Application No. 25837 Permit No. 20295

IN NAME OF

A. L. FUNK

Surveyed 5 - 7 1956, by R. D. BEST