


T. 135, R. 10W.W.M.

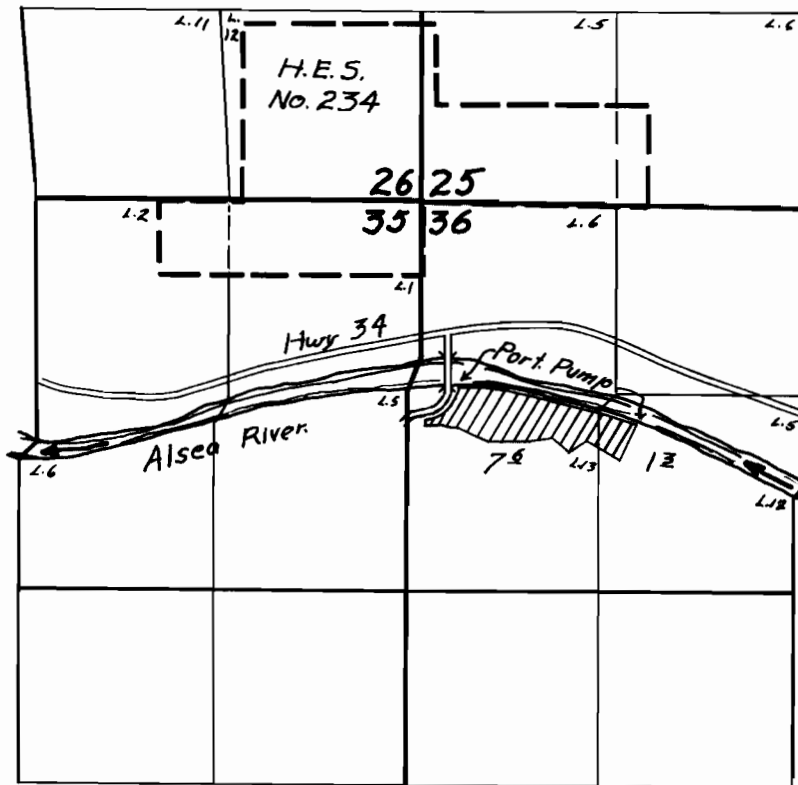

FINAL PROOF SURVEY

UNDER

Application No. 19708... Permit No. 15317.....

IN NAME OF

J. C. BARCLAY

Surveyed 18 April, 1955, by H. L. Coffman.....