


Per 16308
22932

T. 11 S. R. 29 E. W. M.

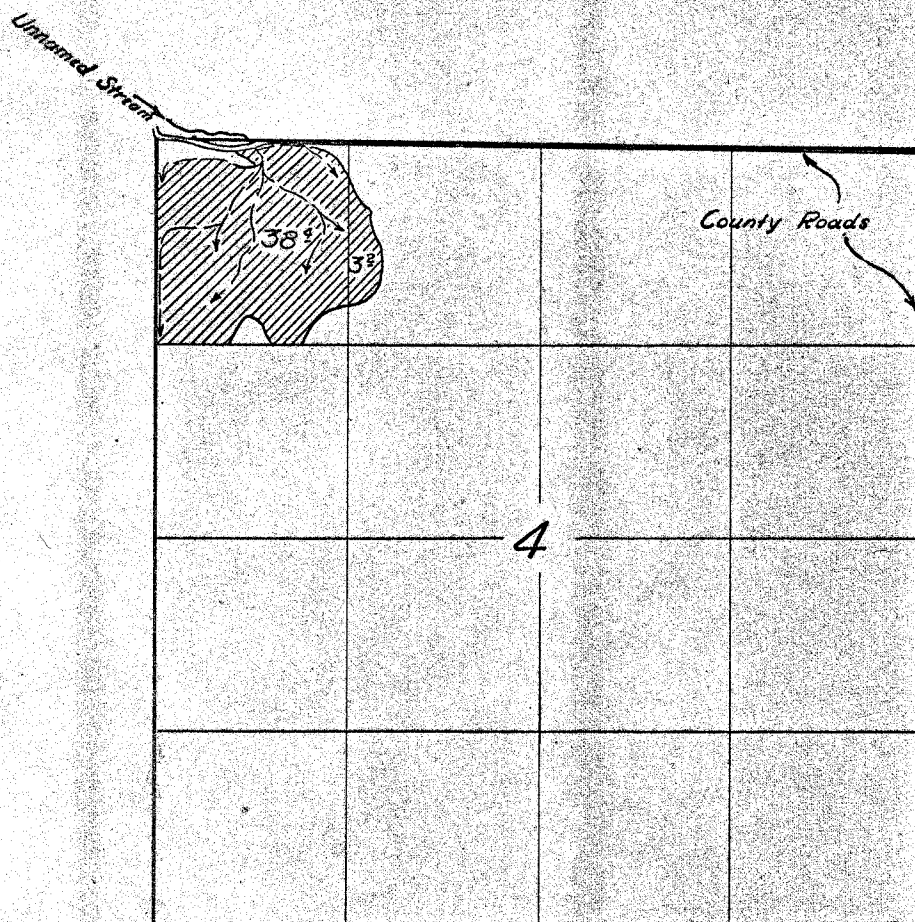

FINAL PROOF SURVEY
UNDER

Application No. 20850 Permit No. 16308
IN NAME OF

W. H. GIENGER

Surveyed 29 Oct. 1956 by C. A. White