


T. 5 N. R. 4 W. W. M.

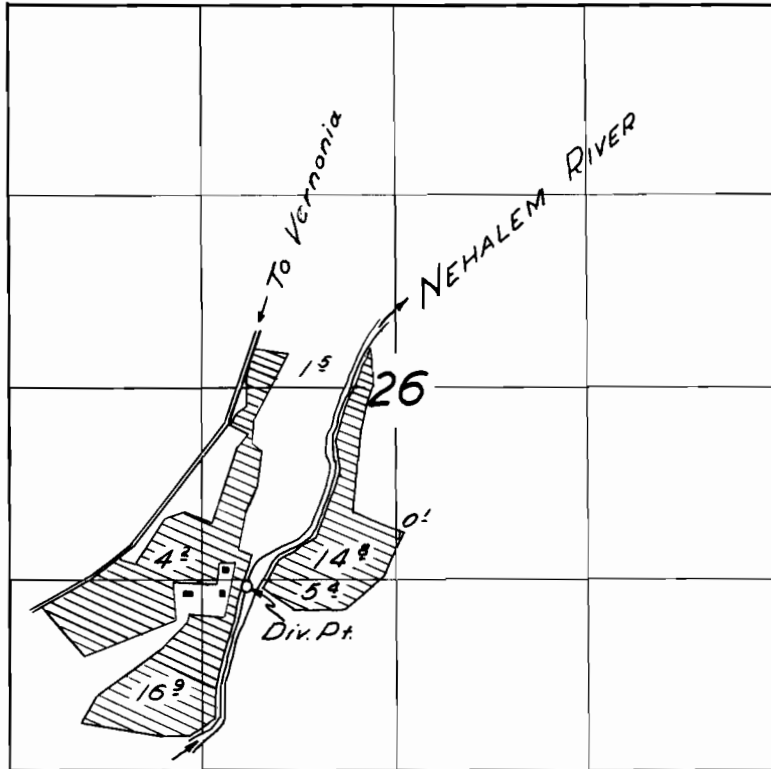

FINAL PROOF SURVEY

UNDER

Application No. 21101 Permit No. 16536

IN NAME OF

L. E. ELLIS

Surveyed 8 Sept. 1956 by [Signature]