


T. 29S., R. 14 & 15W.W.M

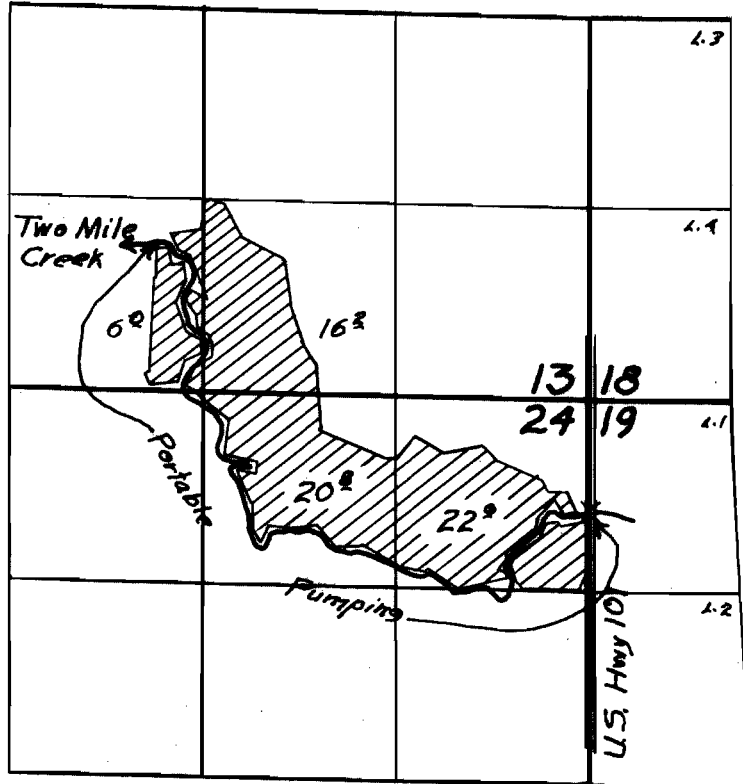

FINAL PROOF SURVEY
UNDER

Application No. 22051... Permit No. 17313...
IN NAME OF

CHRISTIAN F. RICHERT

Surveyed 17. March 1955, by H.L. Coffman...