


T.2S., R.2 W., W.M.

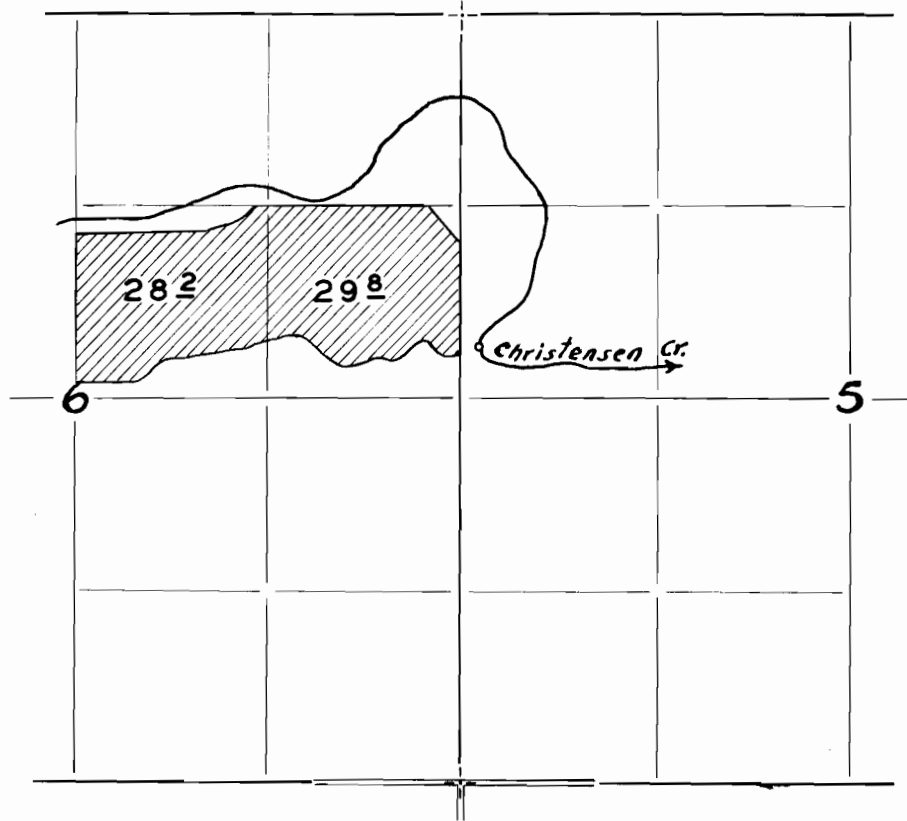

**FINAL PROOF SURVEY**

UNDER

Application No. 22060 Permit No. 17409

IN NAME OF

CHRISTENSEN BROS.

Surveyed 5-3 1956, by M. BISH