


T.5 S. R. 4 W.W.M.

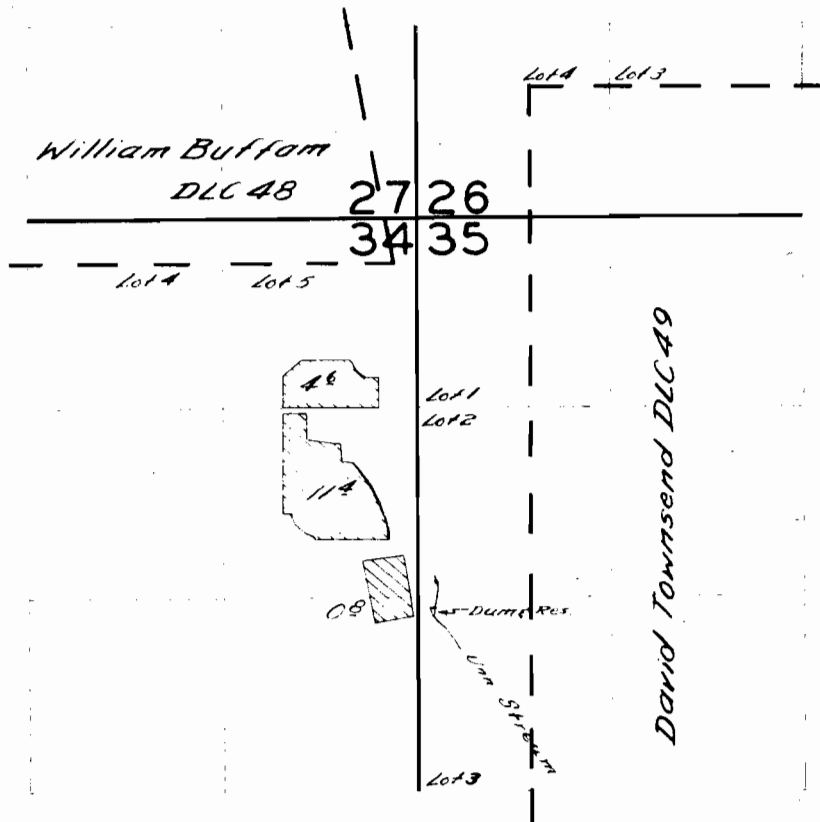

UNITED STATES DEPARTMENT OF THE INTERIOR
BUREAU OF LAND MANAGEMENT
R-26104 26105 24556 R-1409 21661 19362
B.L.M.

ED O'REILLY

Mar 27 56 C.O. Bartels