


T. 4S. R. 2E. W.M.

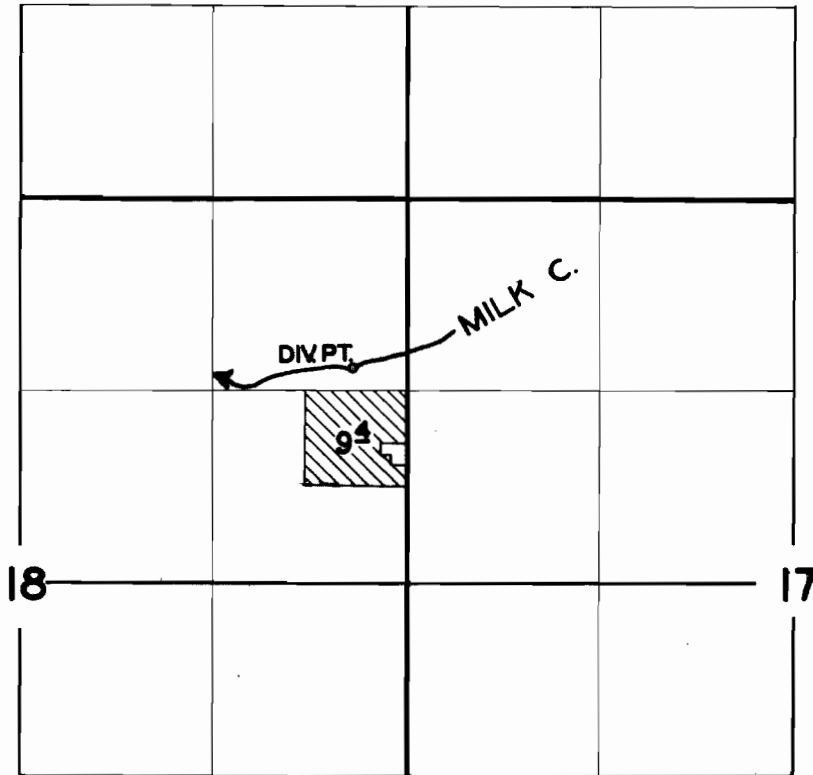

**FINAL PROOF SURVEY**

UNDER

Application No. 25991 Permit No. 20365

IN NAME OF

JOHN KIRKPATRICK

Surveyed 12 MAR 1956, by R.D. BEST

DFK - 3D - 121

*Best*