


T. 3 & 4 S. R. 4 W. W.M.

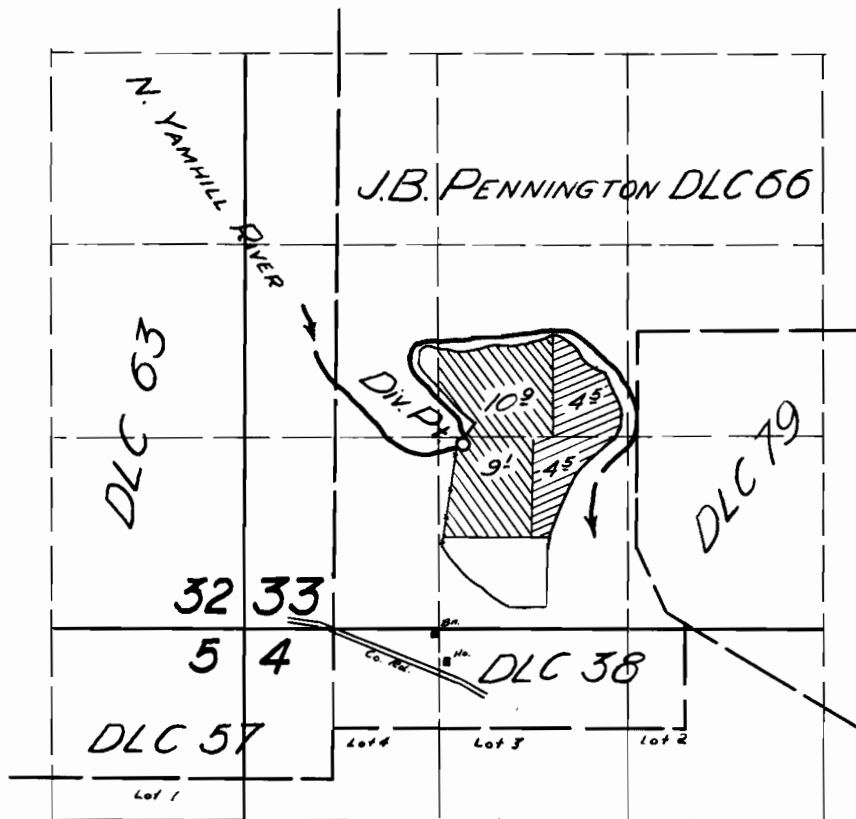

FINAL PROOF SURVEY

UNDER

25143

19781

Application No. 25994

Permit No. 20336



IN NAME OF

CECIL CRIMMINS

Surveyed 2 Apr. 1956, by