


T. 4 N. R. 4 W W. M.

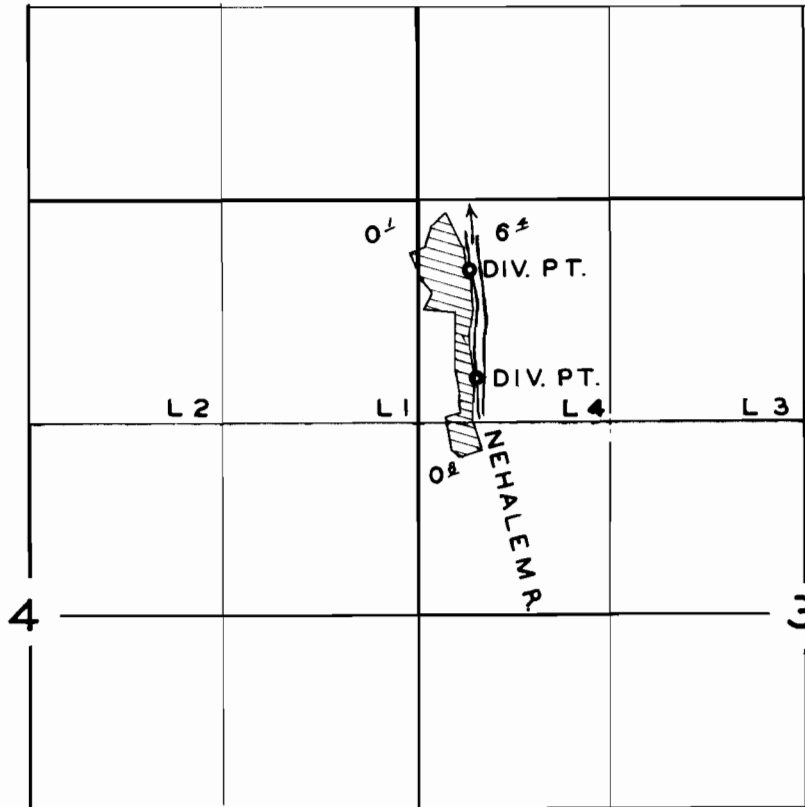

FINAL PROOF SURVEY

UNDER

Application No. 26110 Permit No. 20406

IN NAME OF

GEORGE D. WELLS

Surveyed SEPT. 13 1956, by R. H. WHITBY