


T. 2S. R. 2E. W.M.

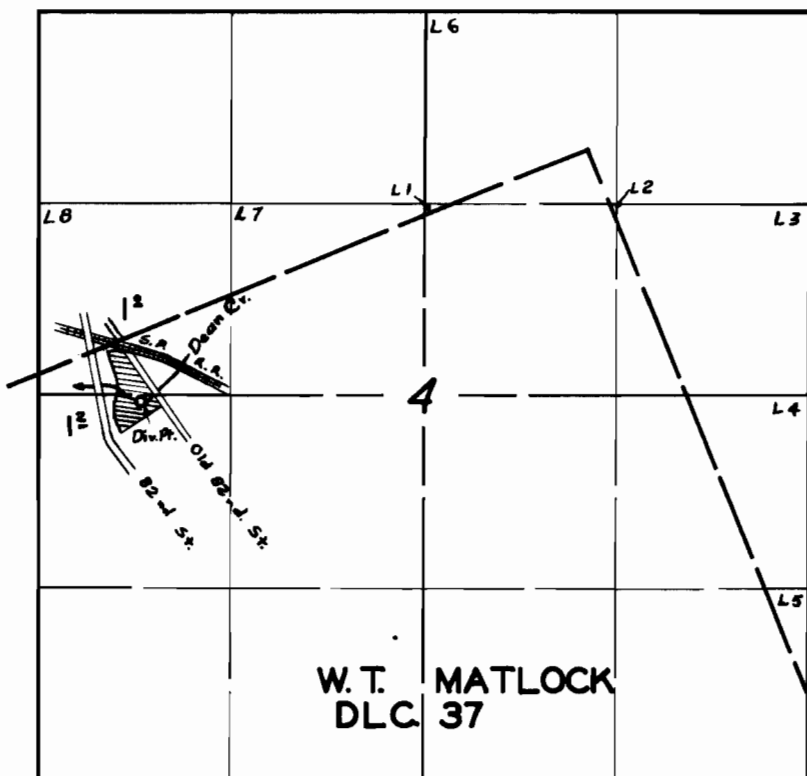

**FINAL PROOF SURVEY**

UNDER

Application No. 26125 Permit No. 20409

IN NAME OF

HOWARD MARTIN

Surveyed 14 May 1956, by M. Bish

DFK-3D-144

RMS