


T.6 S. R. 1 E. W. M.

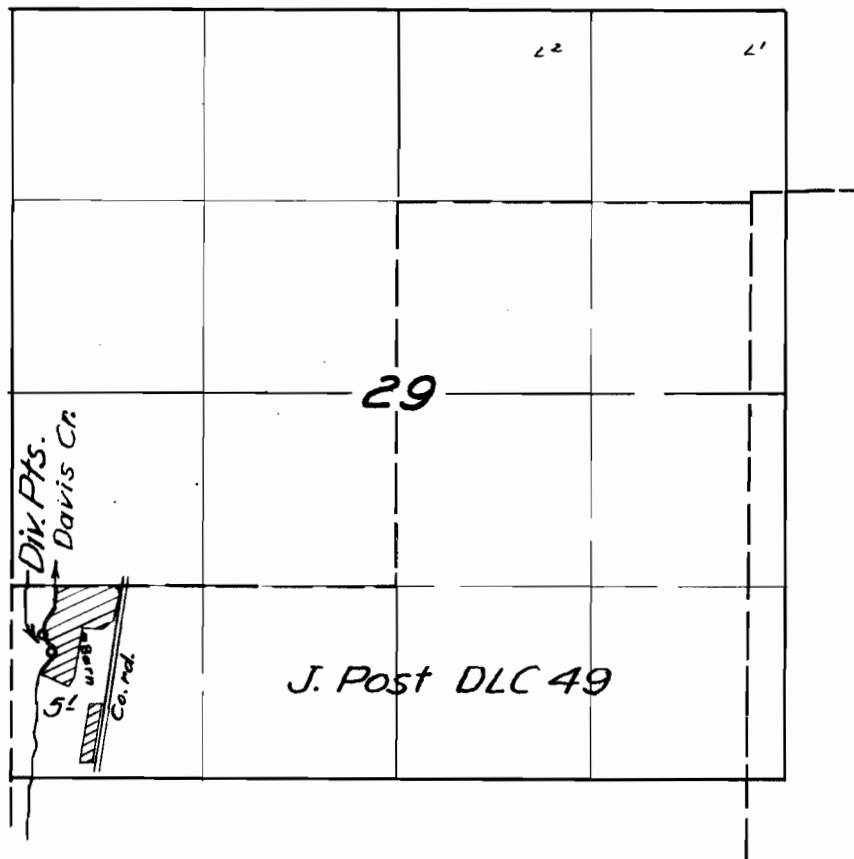

FINAL PROOF SURVEY

UNDER

Application No. 25953 Permit No. 20545

IN NAME OF

John R. Ross Jr.

Surveyed 7 Aug. 1956 by M. Bish