


T.25S. R.7W.W.M.

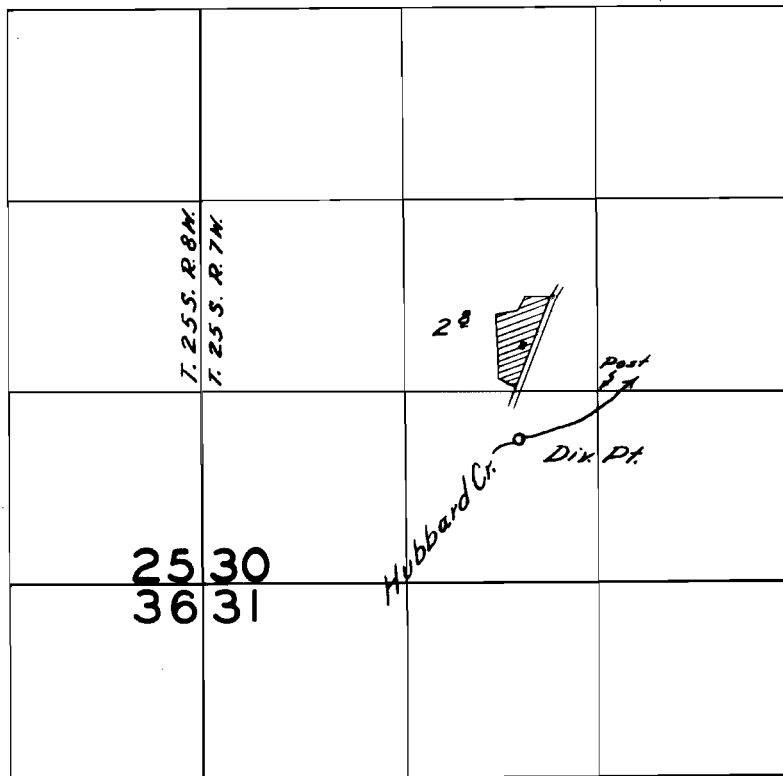

FINAL PROOF SURVEY

UNDER

Application No. 26275... Permit No. 20623...

IN NAME OF

.....*B. W. Travis*.....

Surveyed *Aug. 25* 1956, by *G. A. Bartels*.