


T. 4S. R. 3E. W.M.

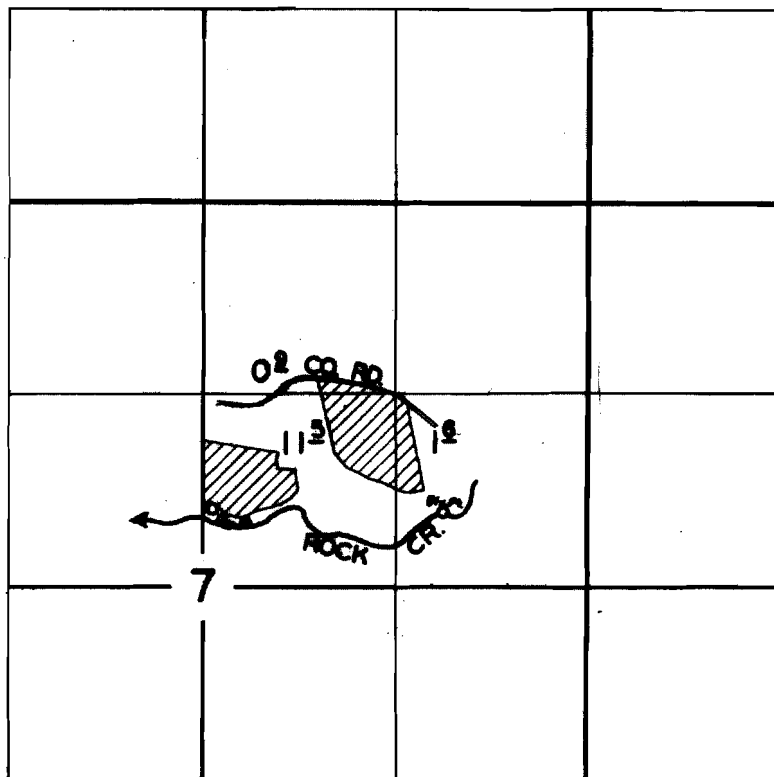

FINAL PROOF SURVEY

UNDER

Application No. 26315 Permit No. 20654

IN NAME OF

JOHN WIEGELE

Surveyed 4 APR. 1956, by R.D. BEST

DFK-ID-87