


T. 4 N. R. 4. W. W. M.

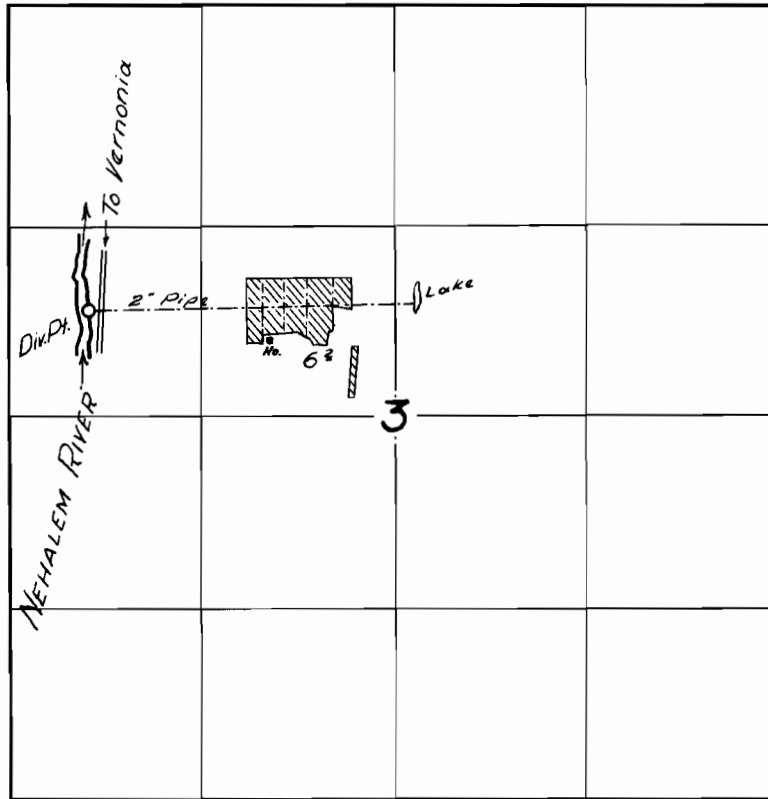

**FINAL PROOF SURVEY**

UNDER

Application No. 26359, Permit No. 20680

IN NAME OF

**ALBERT F. SCHALOCK**

Surveyed 10 Sept 1956, by *Chas. H. [Signature]*