


T.3 N., R. 33 E., W.M.

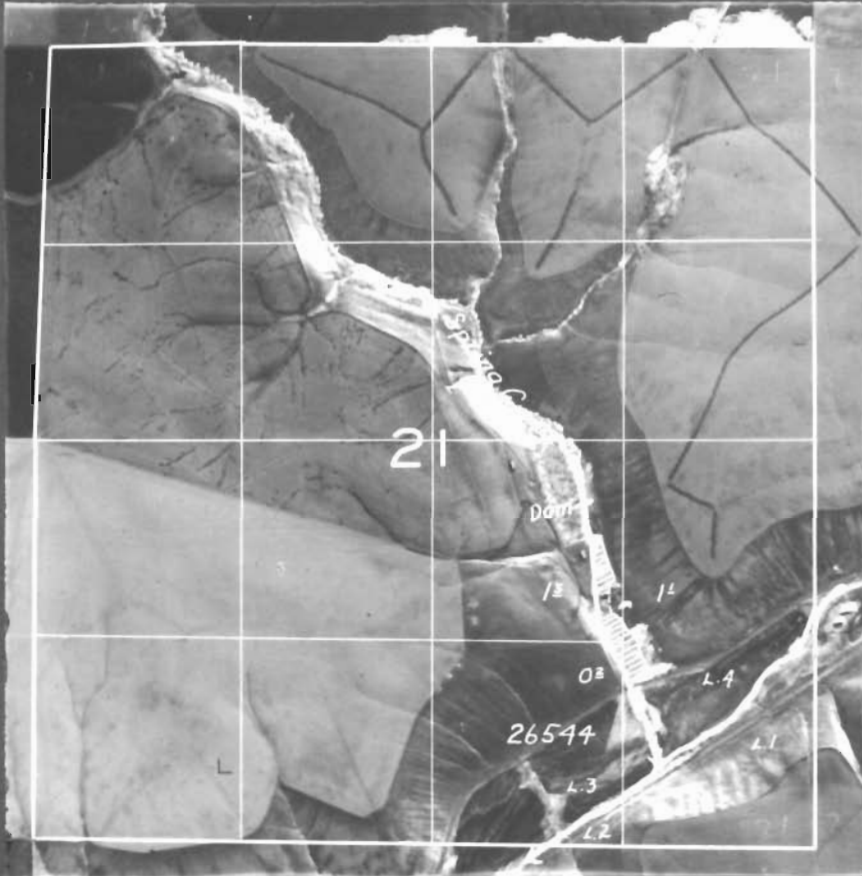

**FINAL PROOF SURVEY**  
UNDER

Application No. 26544 Permit No. 20801  
IN NAME OF

Elmer J. Pahl

Surveyed May 18, 1954, by T. Jones

NZ-2F-97