


T. 5 S. R. 1 W. W.M.

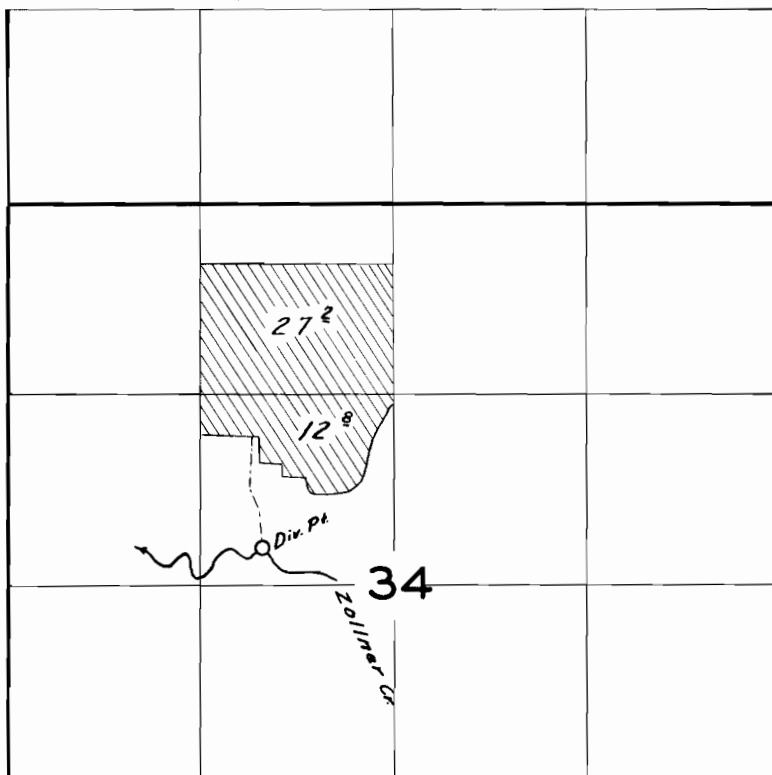

FINAL PROOF SURVEY

UNDER

Application No. 26651 Permit No. 20875
IN NAME OF

L. J. Fessler

Surveyed June 1 1956 by *C.O. Bartels*