


T.29 S. R.5 W.W.M.

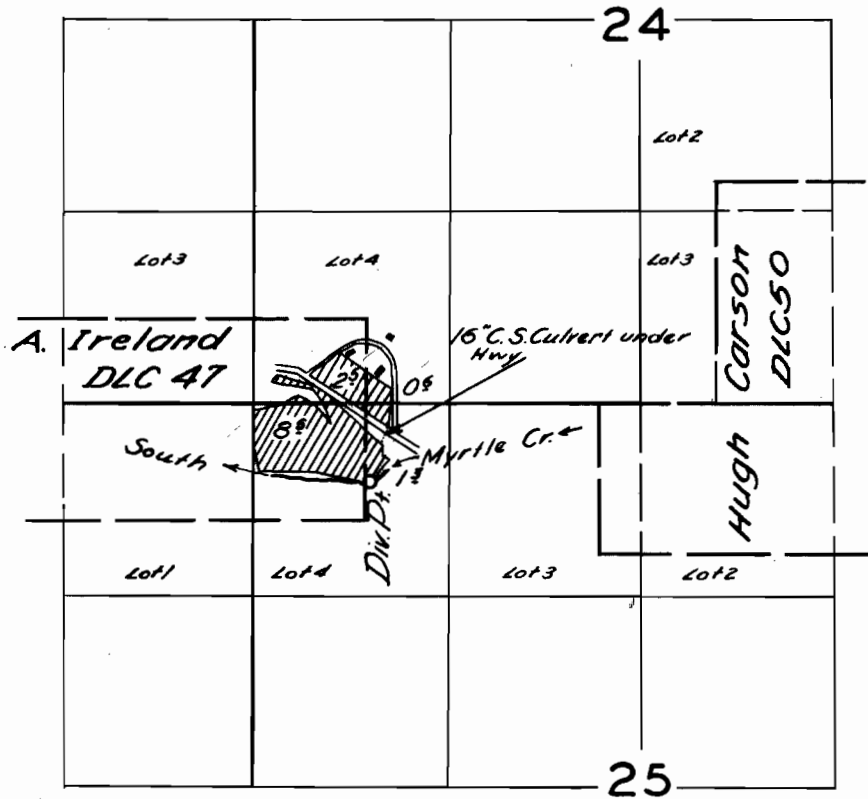

FINAL PROOF SURVEY

UNDER

Application No. 26715 Permit No. 20909

IN NAME OF

GEORGE TRASK

Surveyed Sept. 27 1956, by [Signature]