


T. 6N. R. 5W. W. M.

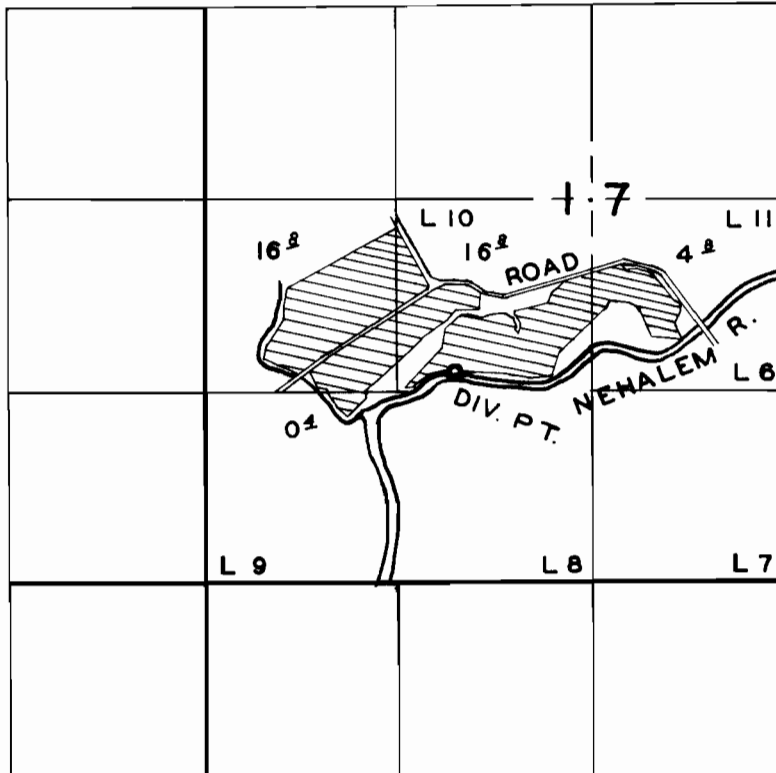

**FINAL PROOF SURVEY**  
UNDER

Application No. 26725. Permit No. 20915...  
IN NAME OF

**HOWARD G. JONES**

Surveyed AUG. 30. 1956, by B. H. WHITBY.

1958 V  
R. H. &