


T. 5 N. R. 7 W. W. M.

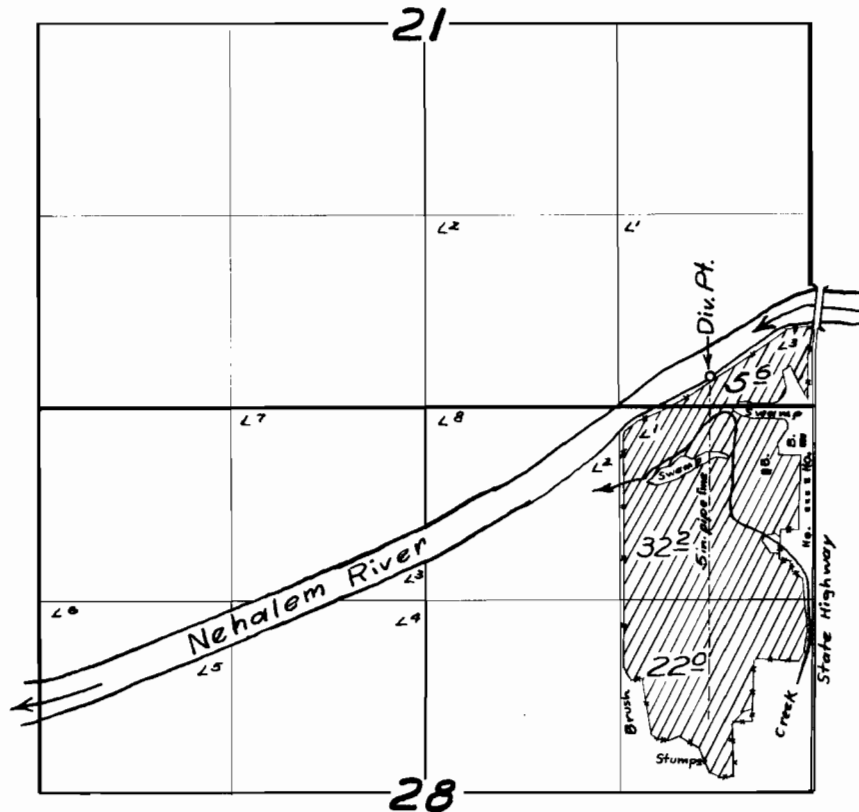

# FINAL PROOF SURVEY

UNDER

Application No. 26811. Permit No. 20945

IN NAME OF

John Jeppesen

Surveyed 11 July 1956 by M. A. Bick

1956-J