


T. 29 S. R. 5 W. W.M.

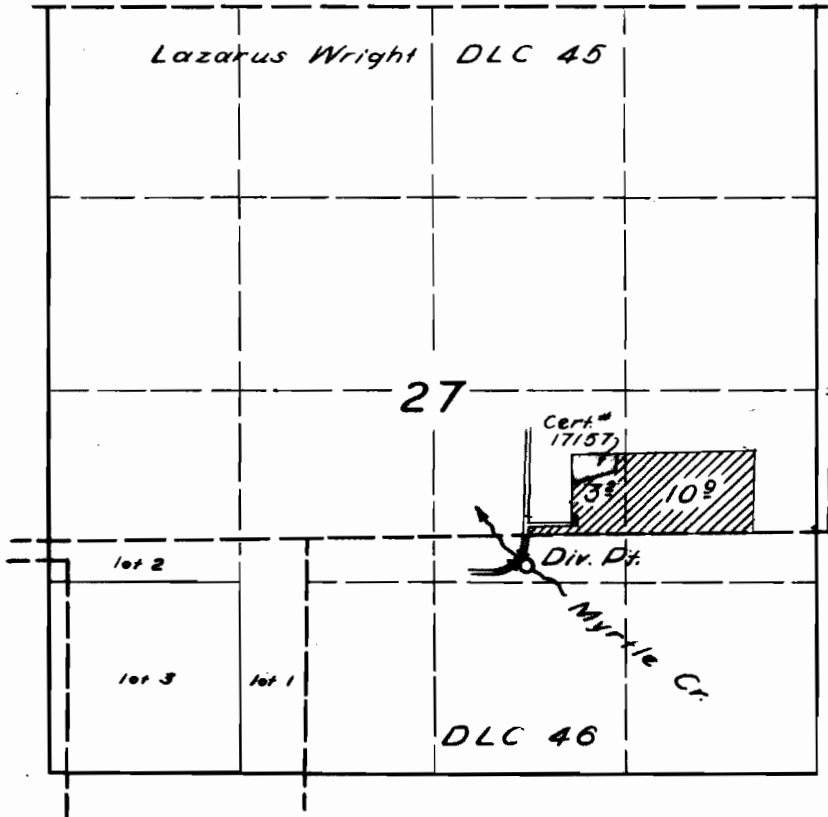

FINAL PROOF SURVEY
UNDER

Application No. 26756 Permit No. 21032
IN NAME OF

KENNETH FOX

Surveyed 30 Sept 1956, by [Signature]