


T. 4S. R. 2E. W.M.

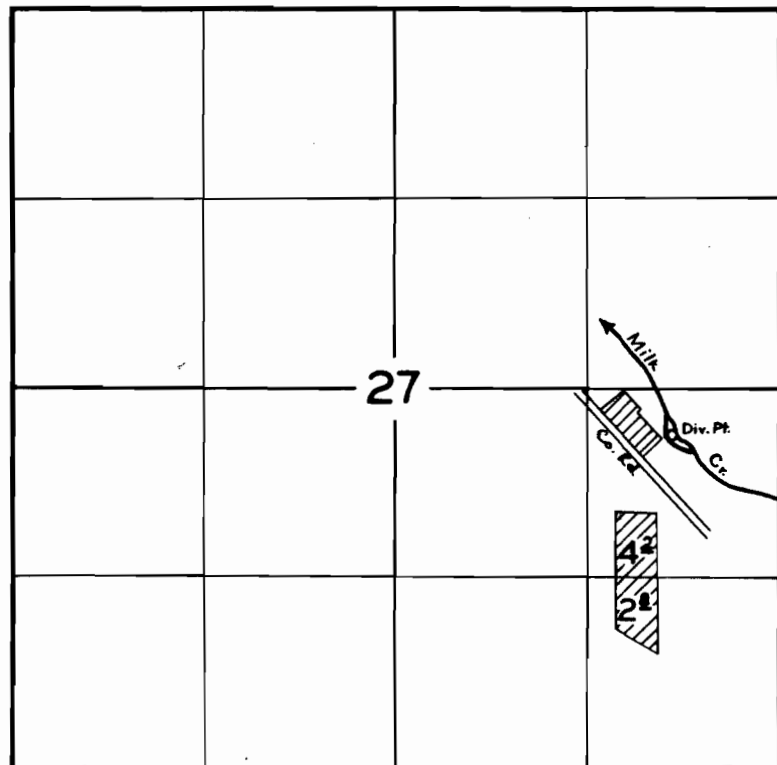

FINAL PROOF SURVEY
UNDER

Application No. 26826 Permit No. 21068
IN NAME OF

HOWARD J. & JEAN A. HUNT

Surveyed 12 MAR. 1956, by R.D. BEST