


T. 6 N. R. 6 W. W. M.

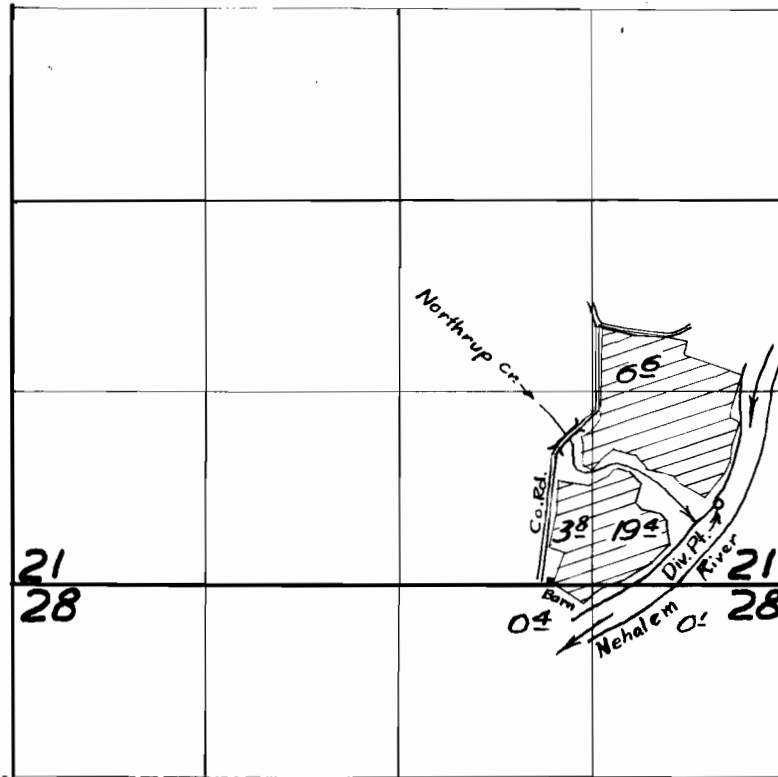

**FINAL PROOF SURVEY**

UNDER

Application No. 26925 Permit No. 21156...

IN NAME OF

Homer Wilcoxen

Surveyed 16 Aug. 1956 by Tom Bish