


T. 29 S. R. 5 W. W.M.

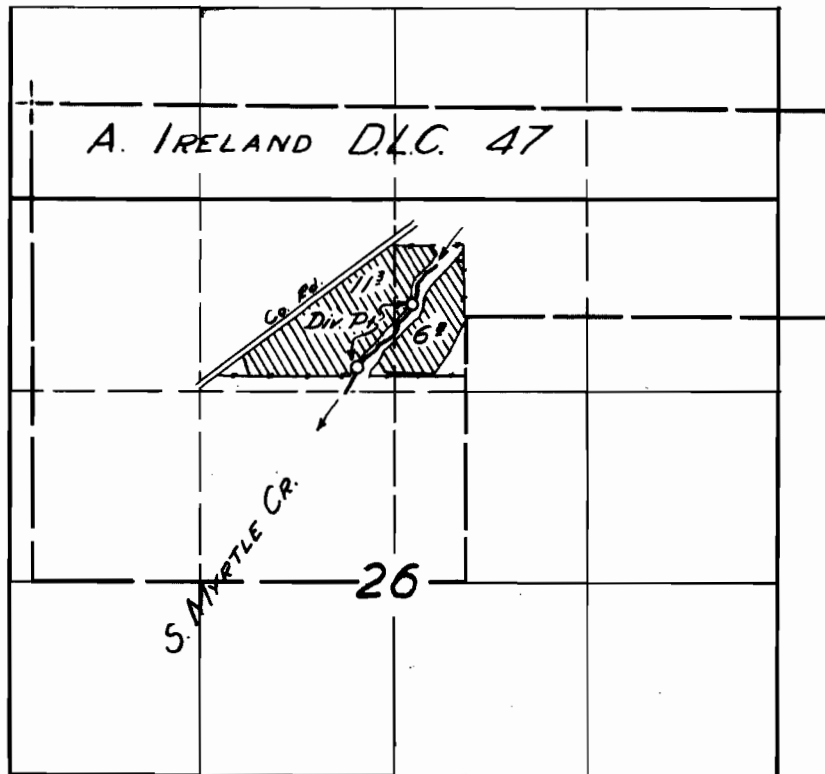

**FINAL PROOF SURVEY**

UNDER

Application No. 26957 Permit No. 21178

IN NAME OF

CHARLES W. & ELIZABETH GORE

Surveyed 29 Sept. 1956, by [Signature]