


T. 10 S. R. 2 W. W.M.

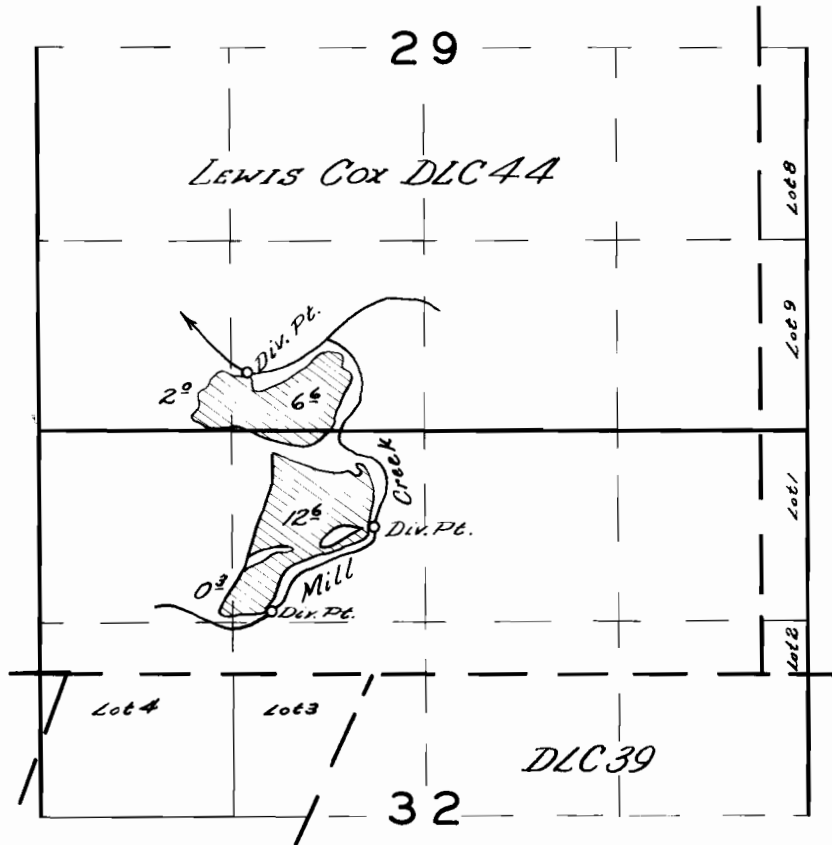

FINAL PROOF SURVEY
UNDER

Application No. *27050* Permit No. *21219*
IN NAME OF

SAM S. & KATHRYN KENNEL

Surveyed *July 27 1956*, by *R. H. Whitty*

DFM-3D-208