


T. 5 N. R. 7 W. W. M.

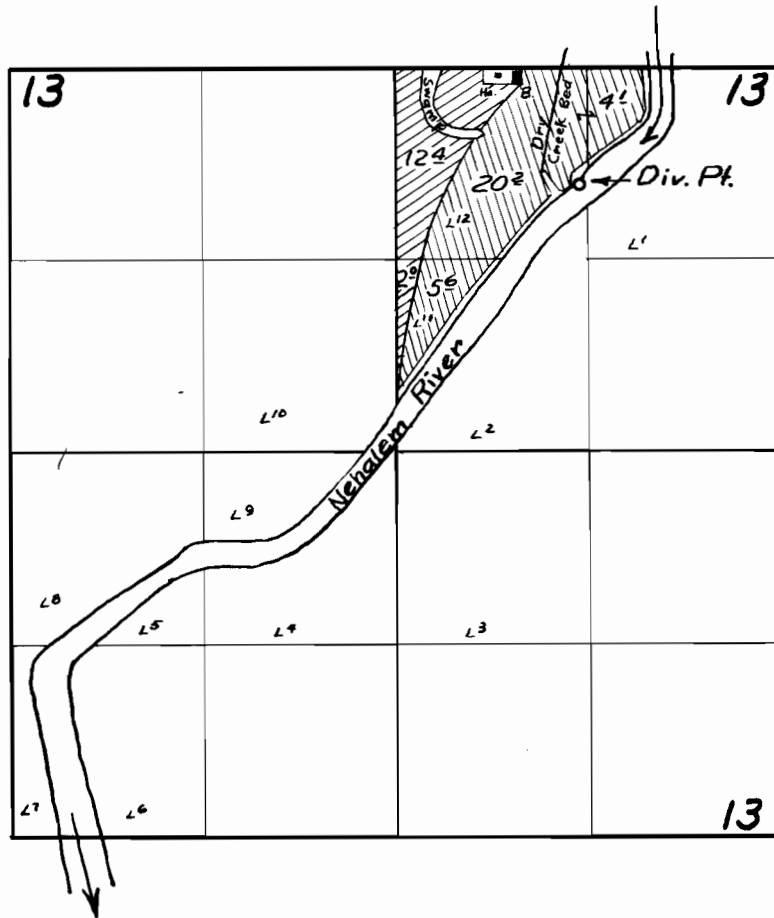

FINAL PROOF SURVEY

UNDER

24391

19241

Application No. 27076 Permit No. 21304

IN NAME OF

MEIER & SONS
MEIER BROS.

Surveyed 13 July 1956, by *M. B. Bish*

1956 J