


T. 5 N. R. 7 W. W. M.

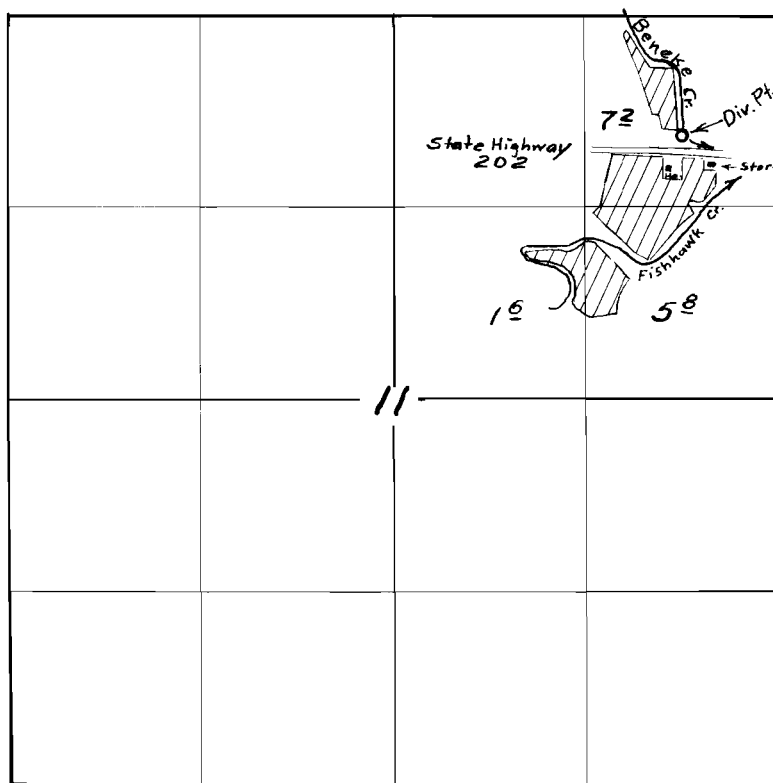

FINAL PROOF SURVEY
UNDER

Application No. 27087 Permit No. 21318
IN NAME OF

Meier Bros.

Surveyed 13 July 1956, by Tom Bish