


T. 10 S. R. 2 W. W.M.

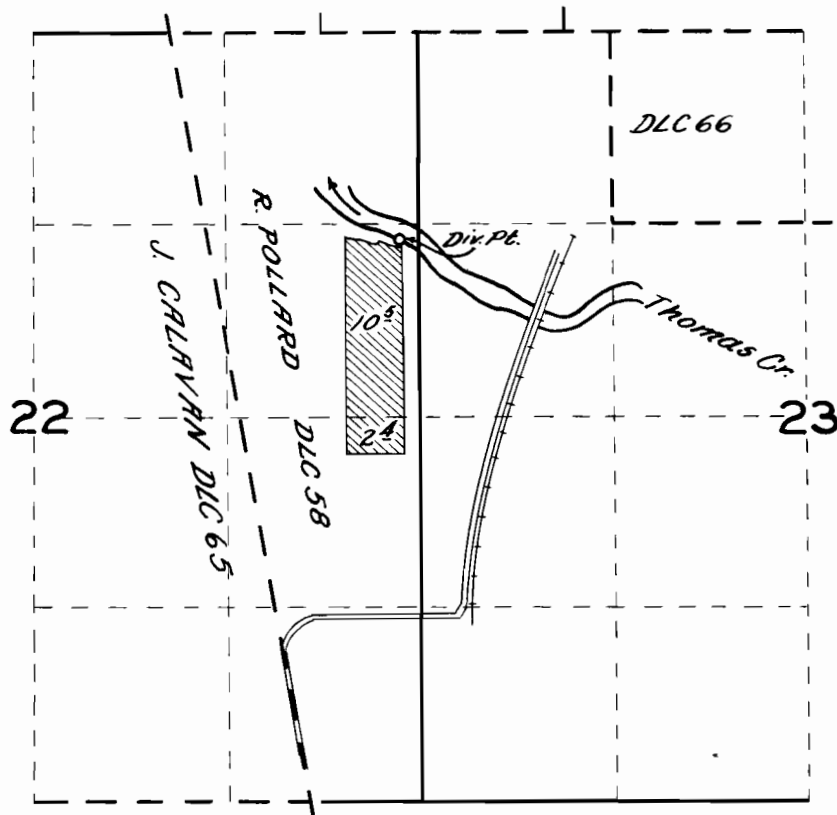

FINAL PROOF SURVEY

UNDER

Application No. 27156 Permit No. 21357

IN NAME OF

B. W. ALBERS

Surveyed July 26 1956, by R. H. Whitby

DFM-20-48

CS.