


T. 9 S. R. 2 W. W. M.

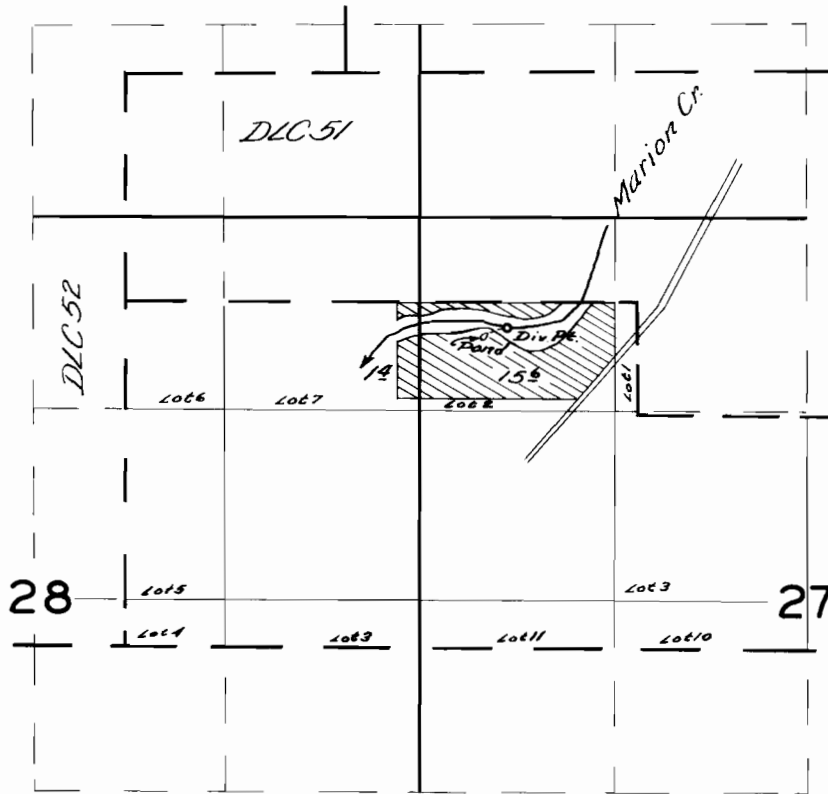

**FINAL PROOF SURVEY**  
UNDER

Application No. 27434 Permit No. 21601  
IN NAME OF

WILLIAM F. WATSON

Surveyed April 20, 1956, by R. H. Whitby

DPN-2D-52