


T.1S. R.3 W. W.M.

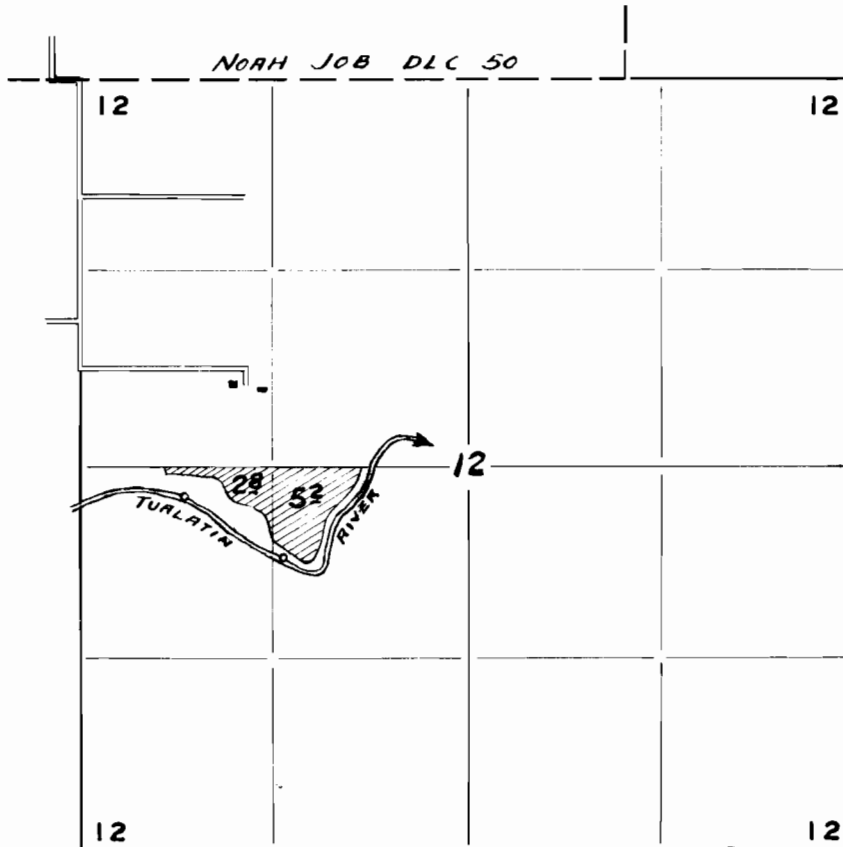

FINAL PROOF SURVEY

UNDER

Application No. 27457 Permit No. 21615

IN NAME OF

JOHN RAYMOND MINTY

Surveyed 4 - 26 1956, by R. H. WHITBY