


T. 7N. R. 3W. W.M.

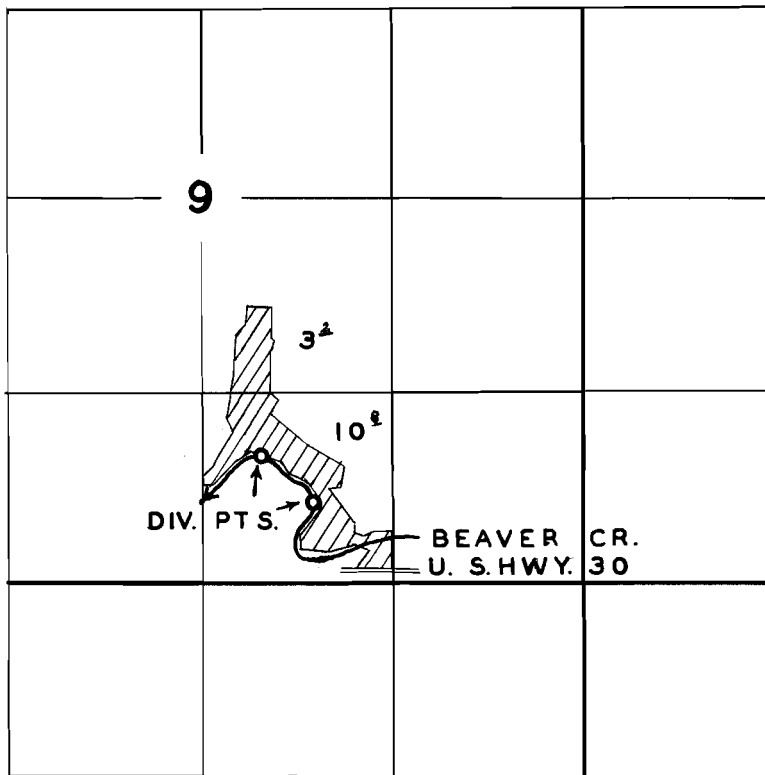

FINAL PROOF SURVEY
UNDER

Application No. 27492 Permit No. 21639
IN NAME OF

EARL G. & JENNIE WATSON

Surveyed AUG. 27. 1956, by R. H. WHITBY