


T. 29 S. R. 4 W. W. M.

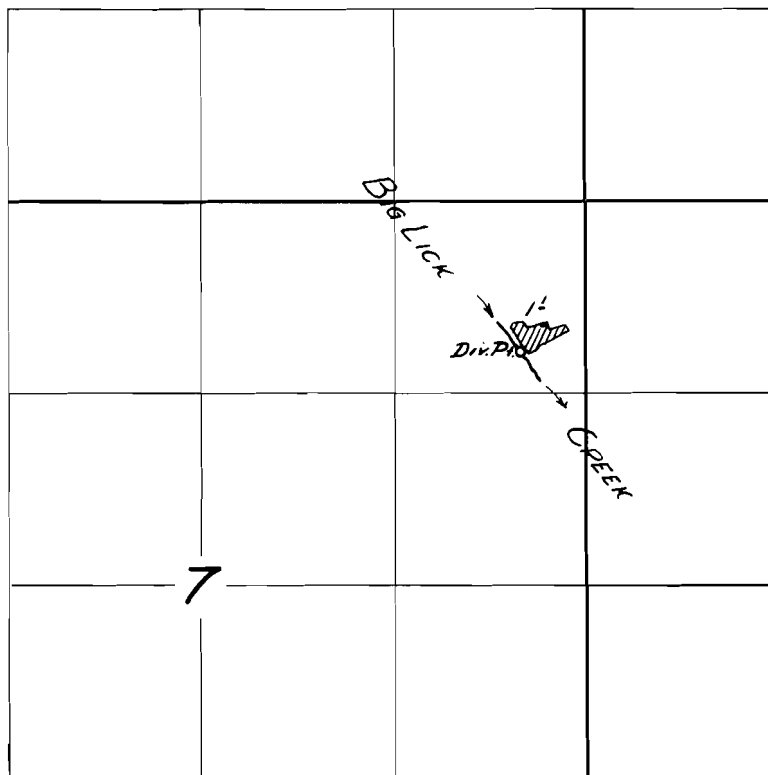

FINAL PROOF SURVEY
UNDER

Application No. 27435 Permit No. 21671
IN NAME OF

MYRL ROSS BARKHURST

Surveyed 26 Sept 1956, by [Signature]